





**AUBURN STREET**

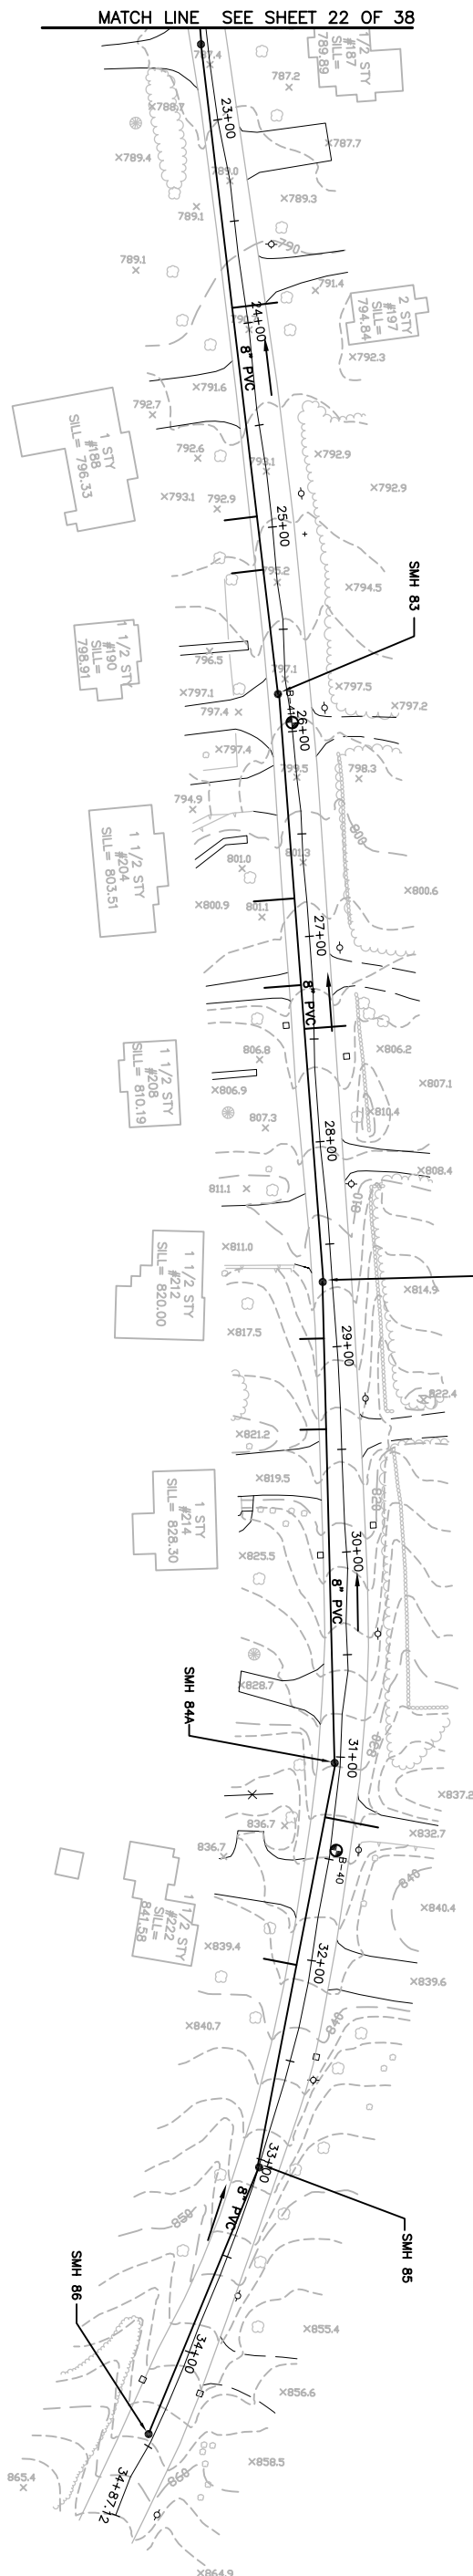

**PLAN**  
SCALE: 1"=40'

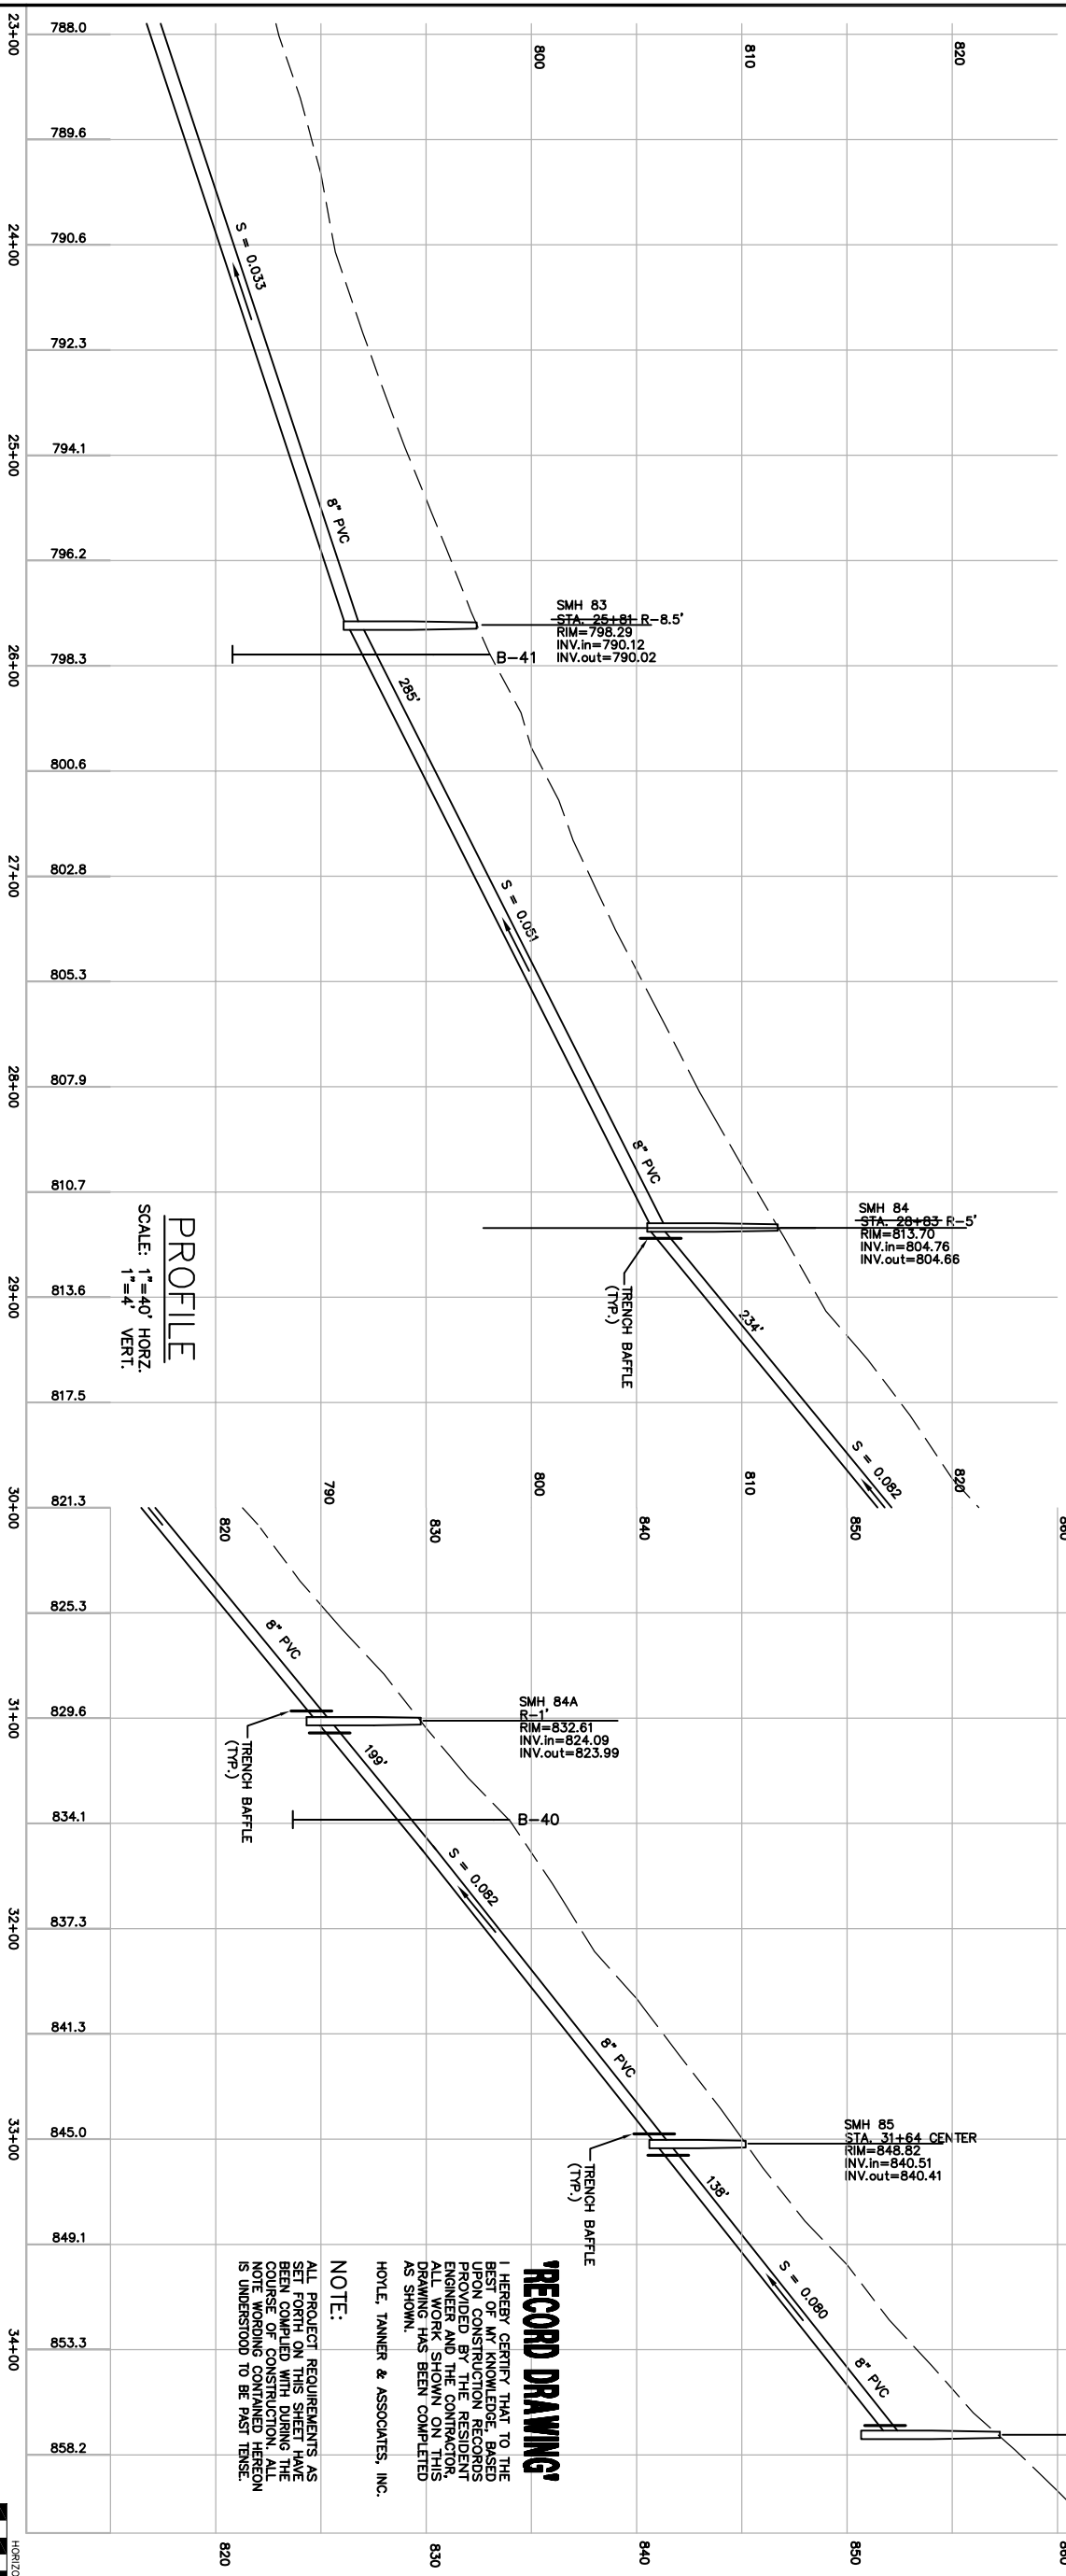


**PROFILE**  
SCALE: 1"=40' HORIZ.  
1"=4' VERT.

**'RECORD DRAWING'**

I HEREBY CERTIFY THAT TO THE BEST OF MY KNOWLEDGE, BASED UPON CONSTRUCTION RECORDS, ENGINEER AND THE CONTRACTOR'S ALL WORK SHOWN ON THIS DRAWING HAS BEEN COMPLETED AS SHOWN.

HOYLE, TANNER & ASSOCIATES, INC.

**NOTE:**  
ALL PROJECT REQUIREMENTS AS SET FORTH ON THIS SHEET HAVE BEEN COMPLETED WITH DURING THE COURSE OF CONSTRUCTION. ALL NOTE WORDING CONTAINED HEREON IS UNDERSTOOD TO BE PAST TENSE.

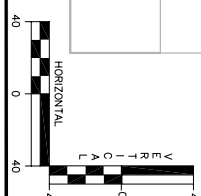

<p style="font-size: 2em; font-weight: bold;">23</p> <p style="font-size: 0.8em;">DRAWING NO.</p>	<p>CHERRY VALLEY SEWER DISTRICT LEICESTER, MASSACHUSETTS</p> <p style="font-size: 0.8em;">PLAN AND PROFILE</p> <p style="font-weight: bold; font-size: 1.2em;">AUBURN STREET</p> <p>STA. 23+00 TO 34+79</p>		<p style="font-size: 1.5em; font-weight: bold;">HTA</p> <p style="font-weight: bold;">Hoyle, Tanner &amp; Associates, Inc.</p> <p style="font-size: 0.8em;">150 Dow Street • Manchester • New Hampshire 03101</p> <p style="font-size: 0.7em;">Consulting Engineers</p>		<p>PROJECT NO.</p> <p style="font-size: 1.2em;">105709</p>	<p style="font-size: 0.8em;">ENGINEER/ARCHITECT</p>												
	<p>SCALE: AS SHOWN    DATE: APRIL 2001</p>		<p>DES. BY: JAH    DR. BY: CAB/RCP    CHKD. BY: NLT</p>		<p>FILE NAME</p> <p style="font-weight: bold;">ABPROF-23</p>													
<p>SHEET 23 OF 38</p>	<table border="1" style="width: 100%; border-collapse: collapse;"> <tr> <td style="width: 10%; text-align: center;">REV.</td> <td style="width: 70%; text-align: center;">DESCRIPTION</td> <td style="width: 10%; text-align: center;">DR. BY</td> <td style="width: 10%; text-align: center;">CHKD. BY</td> <td style="width: 10%; text-align: center;">APPD. BY</td> <td style="width: 10%; text-align: center;">DATE</td> </tr> <tr> <td style="text-align: center;">1.</td> <td style="text-align: center;">RECORD DRAWING</td> <td style="text-align: center;">C.B.</td> <td style="text-align: center;">W.C.</td> <td style="text-align: center;">W.C.</td> <td style="text-align: center;">10/02</td> </tr> </table>					REV.	DESCRIPTION	DR. BY	CHKD. BY	APPD. BY	DATE	1.	RECORD DRAWING	C.B.	W.C.	W.C.	10/02	<p>DO NOT SCALE DRAWING</p>
REV.	DESCRIPTION	DR. BY	CHKD. BY	APPD. BY	DATE													
1.	RECORD DRAWING	C.B.	W.C.	W.C.	10/02													