


MATCH LINE SEE SHI. 3 OF 38


MATCH LINE SEE SHEET 2 OF 38



PLAN
SCALE: 1"=40'

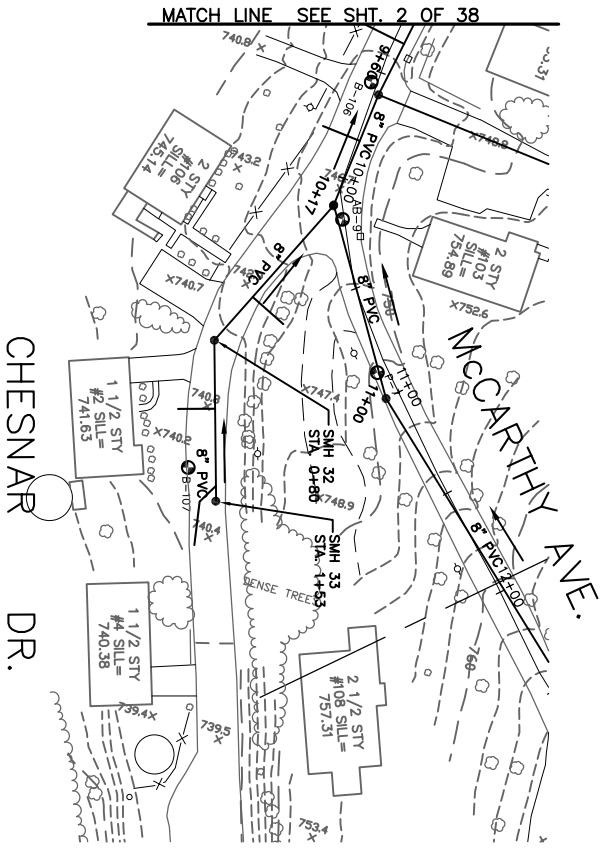

MATCH LINE SEE SHI. 2 OF 38

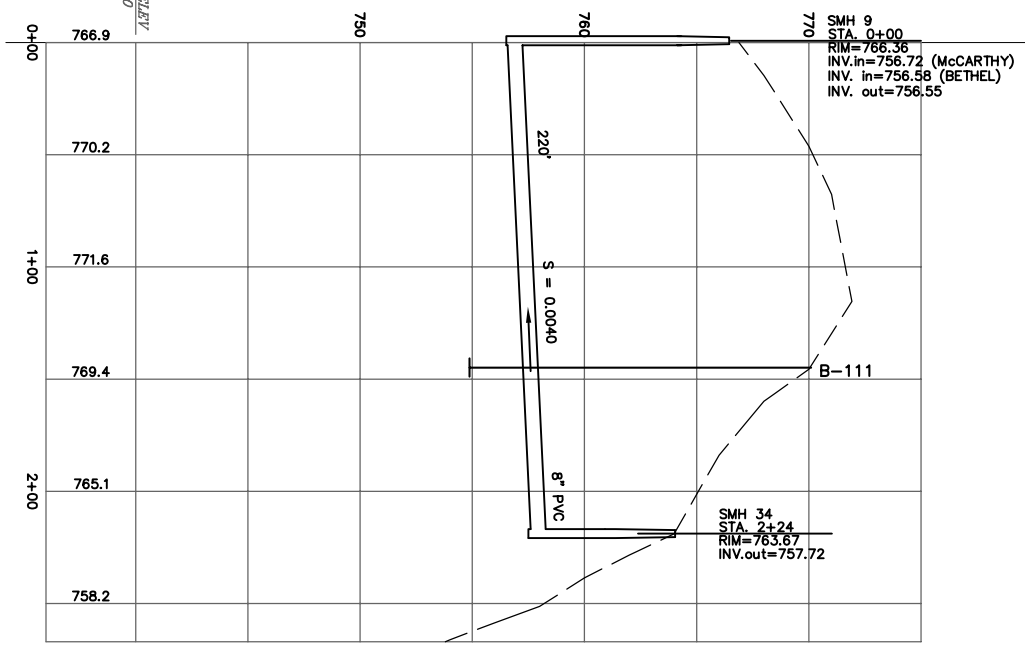


DATE: 01/24/01
740.00

SMH 9
STA. 0+00
RIM=766.36
INV.in=756.72 (McCARTHY)
INV.in=756.58 (BETHEL)
INV.out=756.55

SMH 34
STA. 2+24
RIM=763.67
INV.out=757.72

PROFILE
SCALE: 1"=40' HORIZ.
1"=4' VERT.

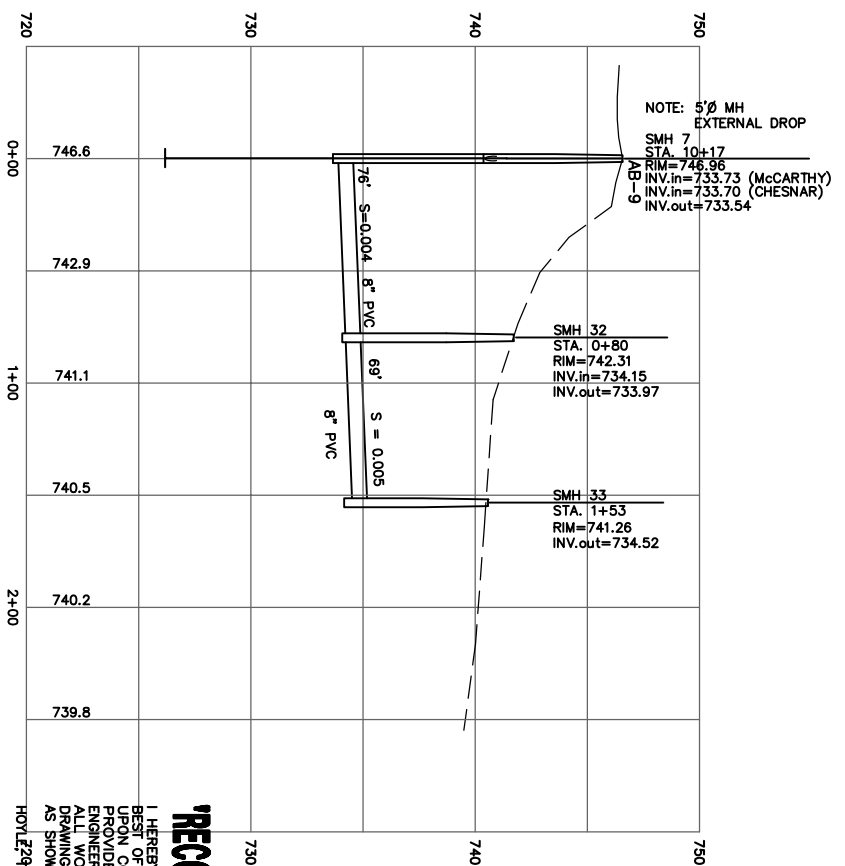


NOTE: 5'Ø MH EXTERNAL DROP
SMH 7
STA. 10+17
RIM=746.96
INV.in=733.73 (McCARTHY)
INV.in=733.70 (CHESNAR)
INV.out=733.54

SMH 32
STA. 0+80
RIM=742.31
INV.in=734.15
INV.out=733.97

SMH 33
STA. 1+53
RIM=741.26
INV.out=734.52

RECORD DRAWING
I HEREBY CERTIFY THAT TO THE BEST OF MY KNOWLEDGE AND BELIEF, THE INFORMATION CONTAINED HEREON IS TRUE AND CORRECT AND THAT I AM A duly Licensed Professional Engineer in the State of Massachusetts.
HOYLE, TANNER & ASSOCIATES, INC.

NOTE:
ALL PROJECT REQUIREMENTS AS SET FORTH ON THIS SHEET HAVE BEEN COMPLIED WITH DURING THE CONSTRUCTION OF THIS PROJECT. THE CONTRACTOR IS RESPONSIBLE FOR VERIFYING THE NOTED WORKING CONDITIONS HEREON IS UNDERSTOOD TO BE PAST TENSE.

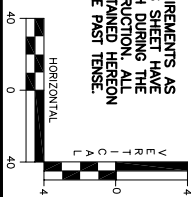

CHERRY VALLEY SEWER DISTRICT
LEICESTER, MASSACHUSETTS
PLAN AND PROFILE
BETHEL AVE. / CHESNAR DR.

HTA Hoyle, Tanner & Associates, Inc.
150 Dow Street • Manchester • New Hampshire 03101
Consulting Engineers

SCALE: AS SHOWN DATE: APRIL 2001 DES. BY: JAH DR. BY: CAB/RCP CHKD. BY: NLT

| | | | |
|----------------------|-------------------|----------------------|-----------|
| PROJECT NO. | 105709 | FILE NAME | ABPROF-08 |
| DO NOT SCALE DRAWING | 1. RECORD DRAWING | C.B. W.C. W.C. 10/02 | |
| REV. | DESCRIPTION | DR. BY | CHKD. BY |
| | | APPR. BY | DATE |