


PLAN
SCALE: 1"=40'

BOTTOMLY AVENUE

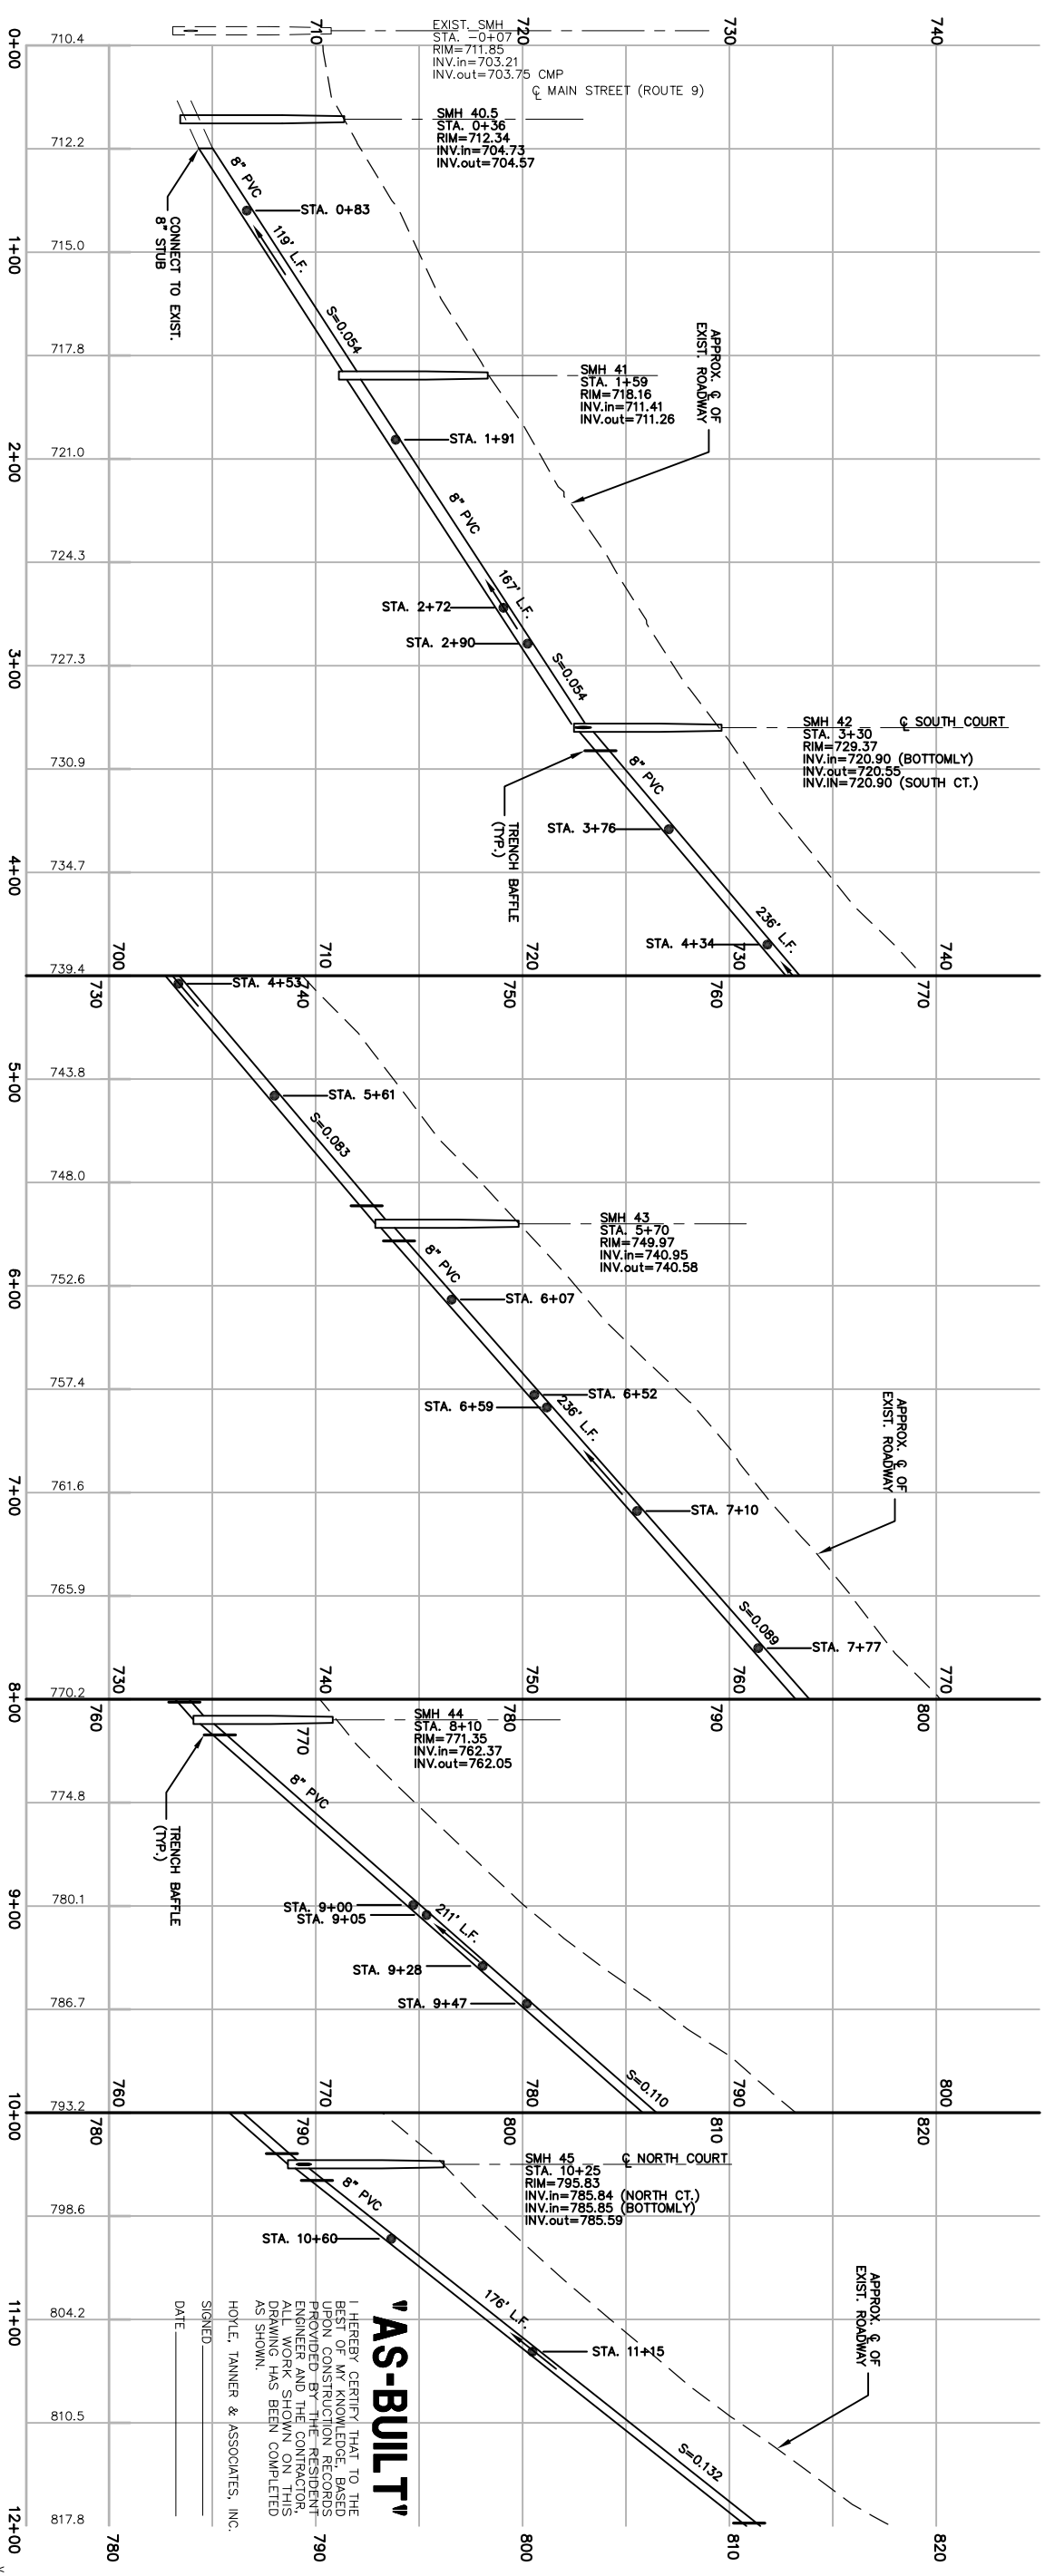


PROFILE
SCALE: 1"=40' HORIZ.
1"=4' VERT.

"AS-BUILT"

I HEREBY CERTIFY THAT TO THE BEST OF MY KNOWLEDGE, BASED UPON CONSTRUCTION RECORDS, PROVIDED BY THE RESIDENTS AND THE RECORD DRAWING, THE WORK SHOWN ON THIS DRAWING HAS BEEN COMPLETED AS SHOWN.

HOYLE, TANNER & ASSOCIATES, INC.
SIGNED _____
DATE _____

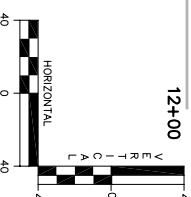

SHEET 11 OF 18	DRAWING NO. 11	CHERRY VALLEY SEWER DISTRICT LEICESTER, MASSACHUSETTS	Hoyle, Tanner & Associates, Inc. 150 Dow Street • Manchester • New Hampshire 03101 Consulting Engineers	PROJECT NO. 105707	ENGINEER/ARCHITECT C.B. J.H. J.H. 12/00 DR. CHKD. APPD. BY DATE		
		PLAN AND PROFILE BOTTOMLY AVENUE 0+00 TO 12+00		FILE NAME AB105P10		DO NOT SCALE DRAWING	
		SCALE: AS SHOWN	DATE: APRIL 2000	DES. BY JAH	DR. BY RCP	CHKD. BY NLT	1. AS-BUILTS REV. DESCRIPTION

MATCH LINE SEE SHEET 12 OF 18