


PLAN
SCALE: 1"=40'

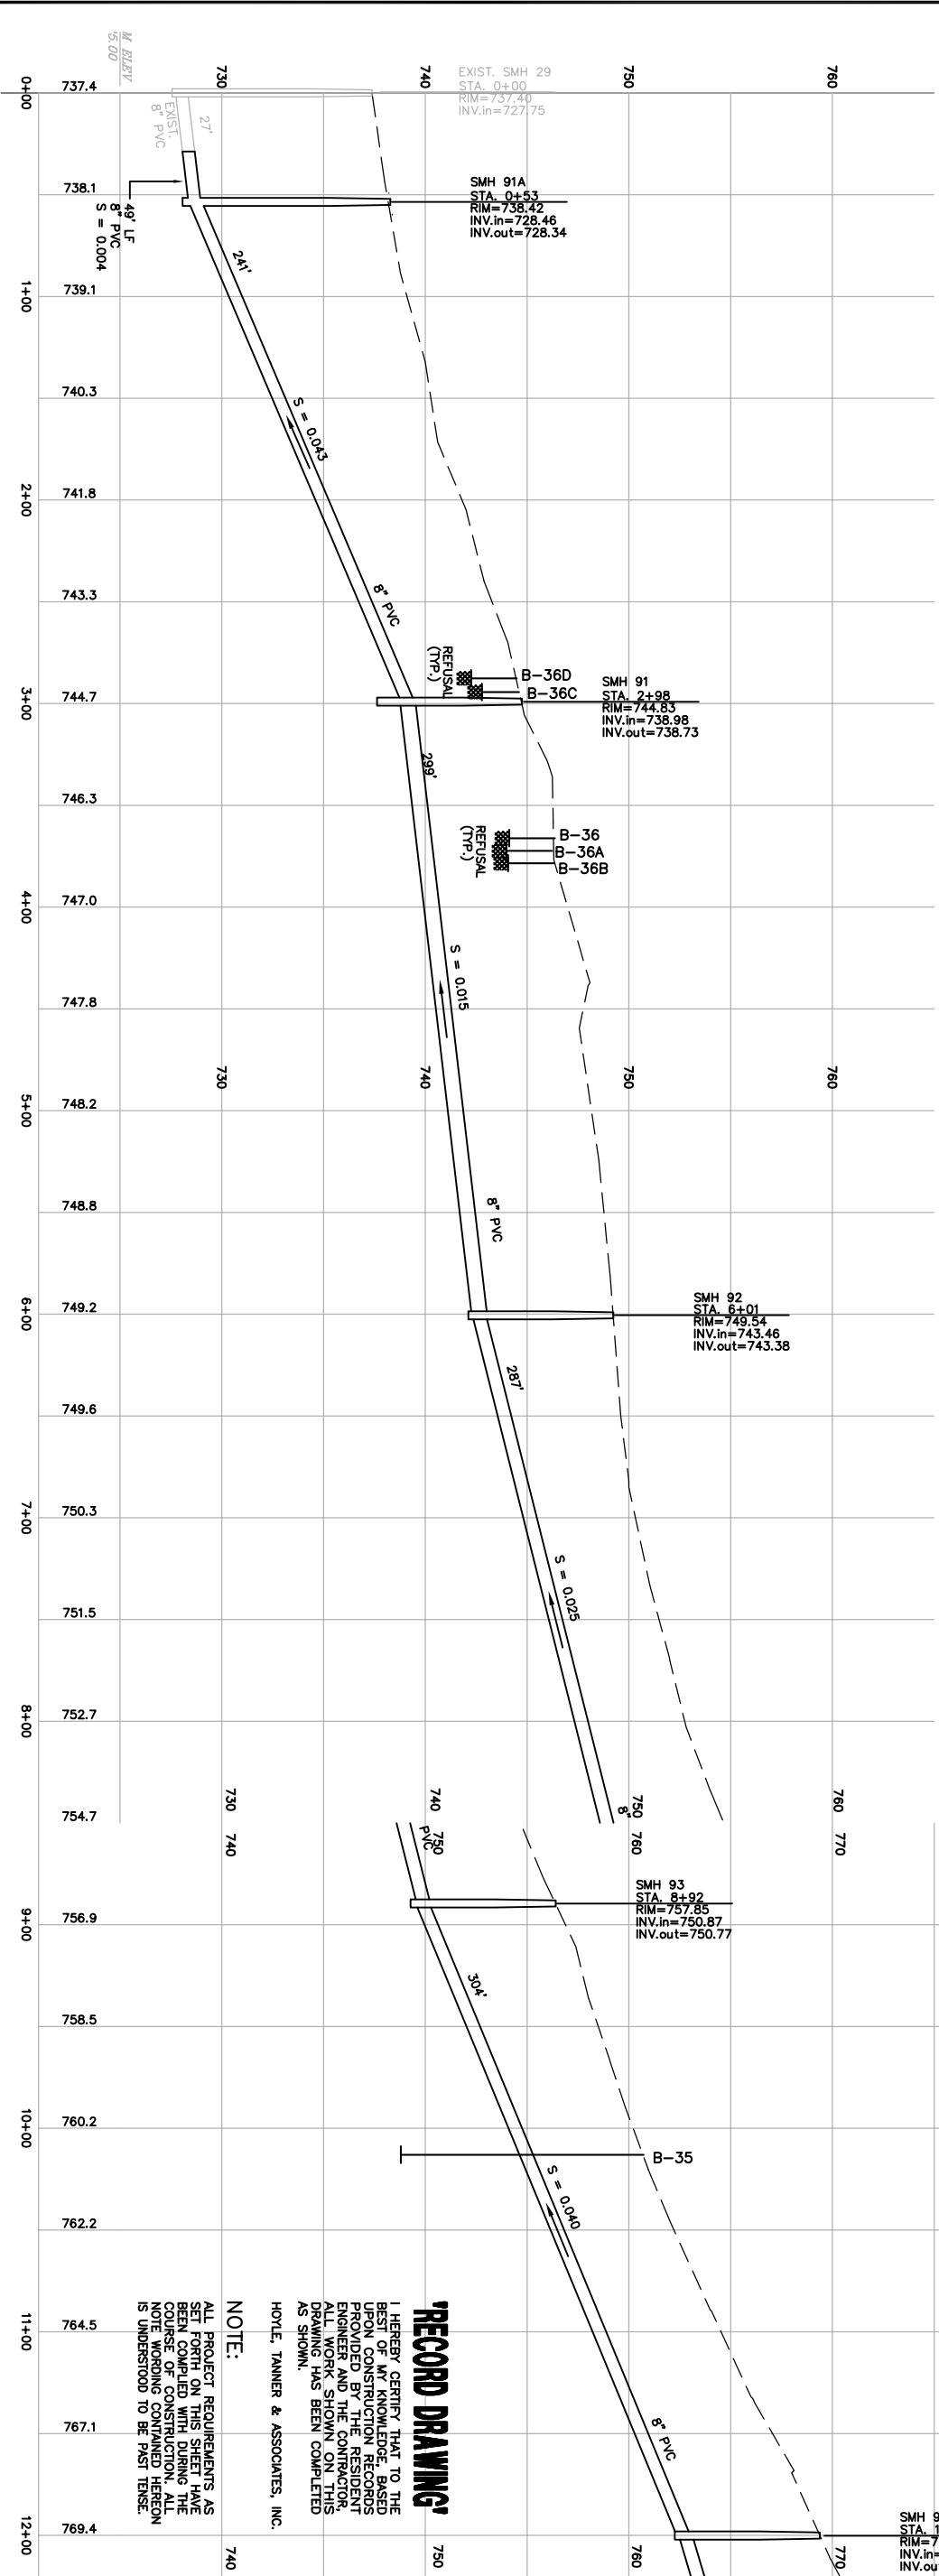

PROFILE
SCALE: 1"=40' HORZ.
1"=4' VERT.


RECORD DRAWING

I HEREBY CERTIFY THAT TO THE BEST OF MY KNOWLEDGE AND BELIEF, THE INFORMATION AND DATA FURNISHED TO ME BY THE CLIENT AND THE RECORDS PROVIDED BY THE RESIDENT ENGINEER AND THE CONTRACTOR, ALL WORK SHOWN ON THIS DRAWING HAS BEEN COMPLETED AS SHOWN.

HOYLE, TANNER & ASSOCIATES, INC.

NOTE:

ALL PROJECT REQUIREMENTS AS SET FORTH ON THIS SHEET HAVE BEEN COMPLIED WITH DURING THE CONSTRUCTION OF THIS PROJECT. THE CONTRACTOR'S RESPONSIBILITY FOR THE WORK SHOWN ON THIS SHEET IS UNDERSTOOD TO BE PAST TENSE.

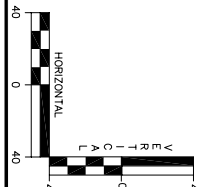

DRAWING NO. 25	CHERRY VALLEY SEWER DISTRICT LEICESTER, MASSACHUSETTS		Hoyle, Tanner & Associates, Inc. 150 Dow Street • Manchester • New Hampshire 03101 Consulting Engineers		PROJECT NO. 105709	ENGINEER/ARCHITECT
	PLAN AND PROFILE		SCALE: AS SHOWN		DATE: APRIL 2001	
SHEET 25 OF 38	CHAPEL STREET STA. 0+00 TO 12+00		DES. BY JAH	DR. BY CAB/RCP	CHKD. BY NLT	DO NOT SCALE DRAWING
FILE NAME ABPROF-24		1. RECORD DRAWING		C.B. W.C. W.C. 10/02		REV. DESCRIPTION
DO NOT SCALE DRAWING		DR. BY		CHKD. BY		APPD. BY
		DATE		DATE		