


PLAN
SCALE: 1"=40'

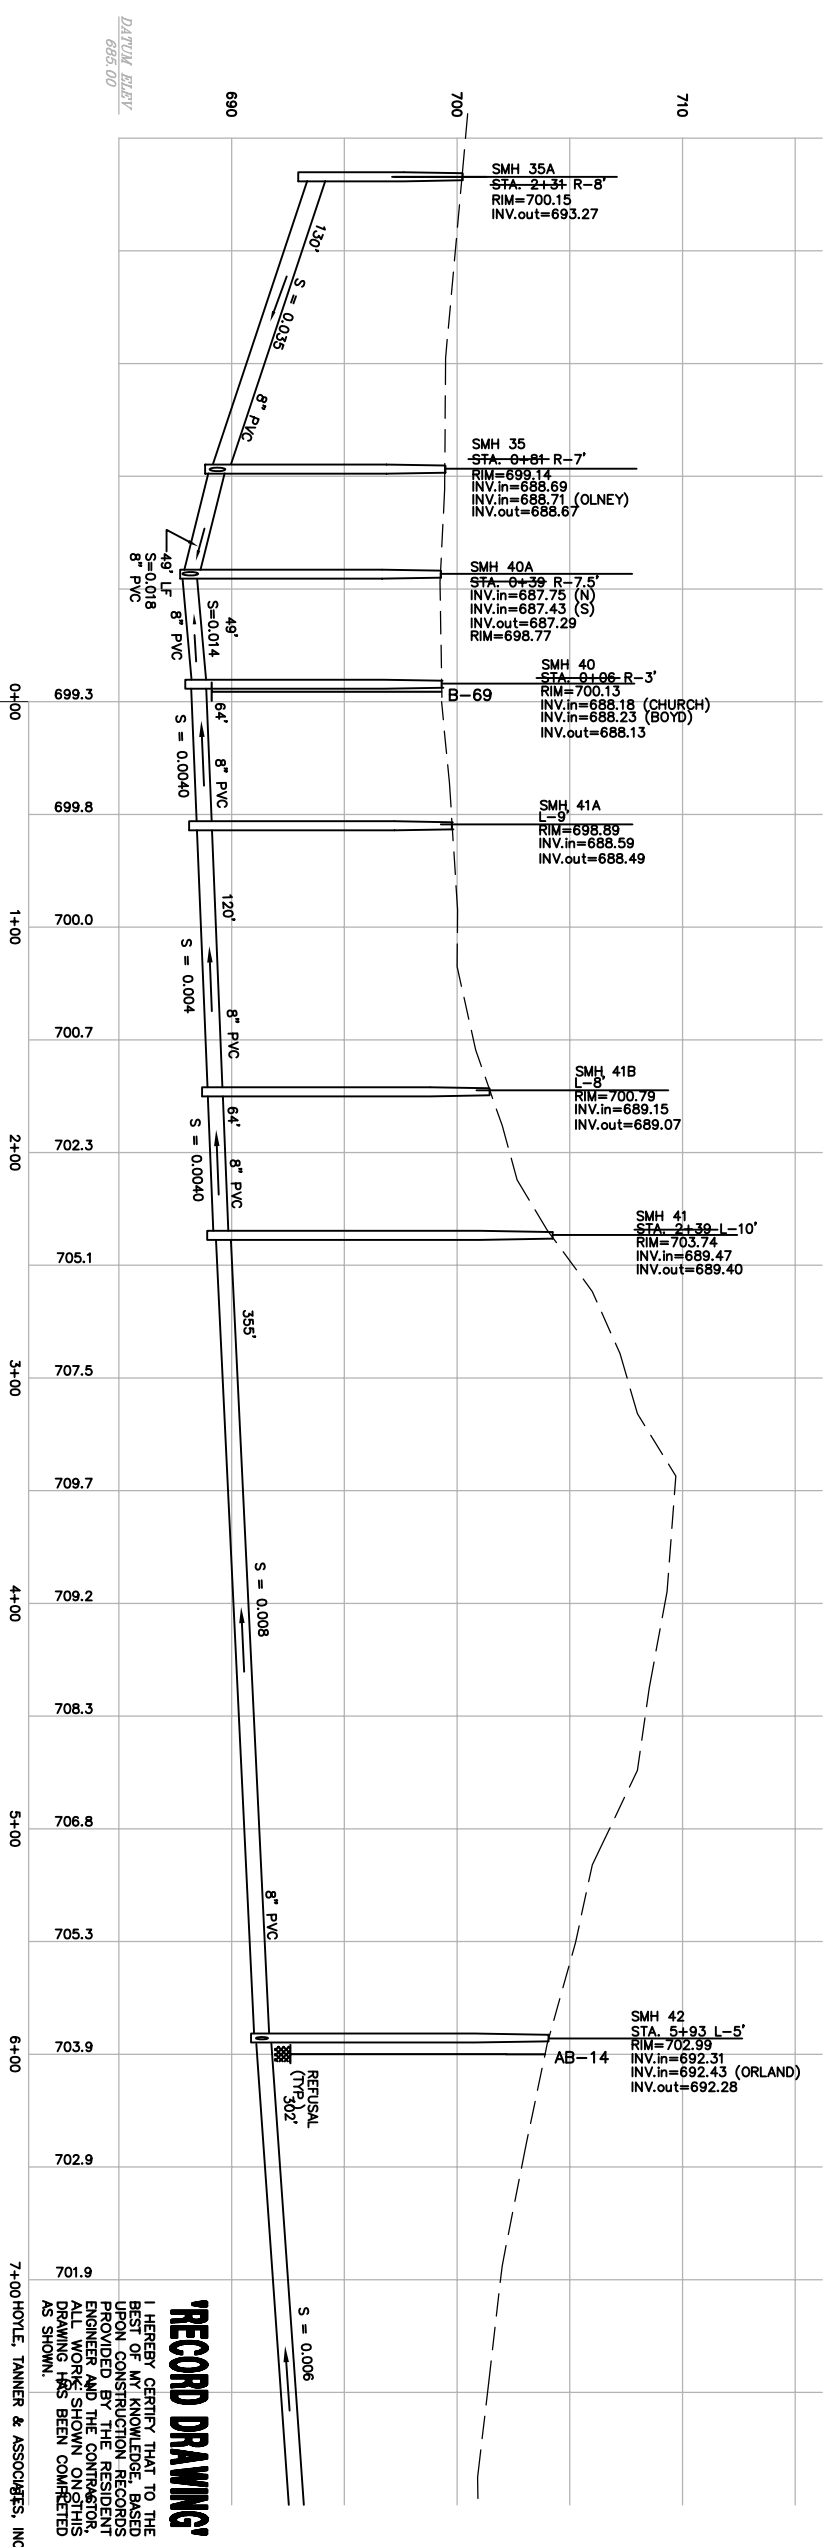

PROFILE
SCALE: 1"=40' HORZ.
1"=4' VERT.


RECORD DRAWING

I HEREBY CERTIFY THAT TO THE BEST OF MY KNOWLEDGE, BASED UPON CONSTRUCTION RECORDS PROVIDED BY THE RESIDENT, ENGINEER AND THE CONTRACTOR, ALL WORK SHOWN ON THIS DRAWING HAS BEEN COMPLETED AS SHOWN.

HOYLE, TANNER & ASSOCIATES, INC.

NOTE:

ALL PROJECT REQUIREMENTS AS SET FORTH ON THIS SHEET HAVE BEEN COMPLETED WITH THE EXCEPTION OF THE WORK SHOWN IN THIS NOTE. WORKING CONTAINED HEREON IS UNDERSTOOD TO BE PAST TENSE.

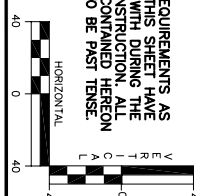

CHERRY VALLEY SEWER DISTRICT
LEICESTER, MASSACHUSETTS

PLAN AND PROFILE

CHURCH ST./BOYD ST.
STA. 0+00 TO 12+00

HTA Hoyle, Tanner & Associates, Inc.
150 Dow Street • Manchester • New Hampshire 03101
Consulting Engineers

SCALE: AS SHOWN DATE: APRIL 2001 DES. BY: JAH DR. BY: CAB/RCP CHKD. BY: NLT

PROJECT NO.	105709	FILE NAME	ABPROF-12
DO NOT SCALE DRAWING			
REV.	DESCRIPTION	DR. BY	CHKD. BY
1.	RECORD DRAWING	C.B.	W.C.
		W.C.	10/02

DRAWING NO. **12**

SHEET 12 OF 38

ENGINEER/ARCHITECT