
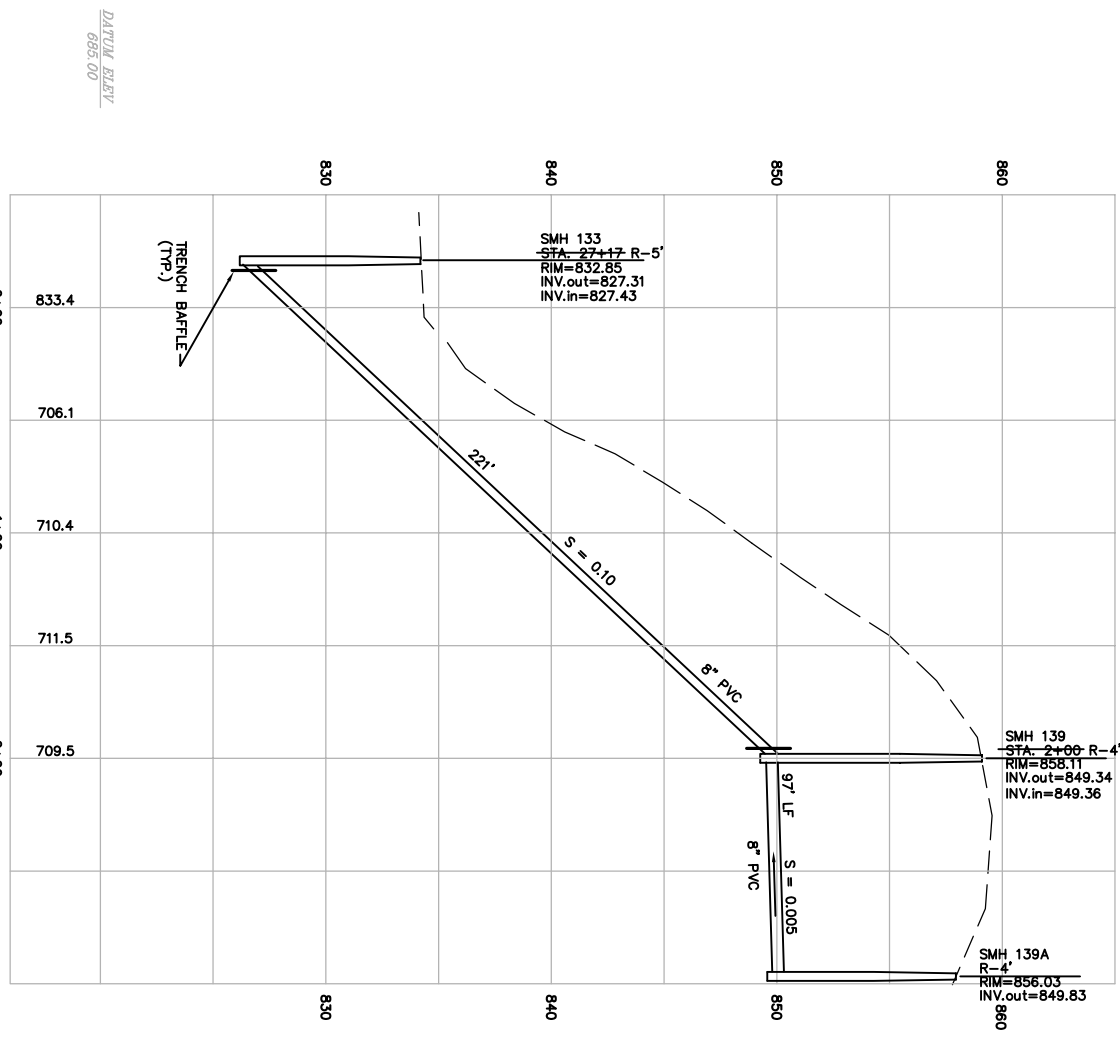


MATCH LINE SEE SHEET 34 OF 38

ENGINEER/ARCHITECT

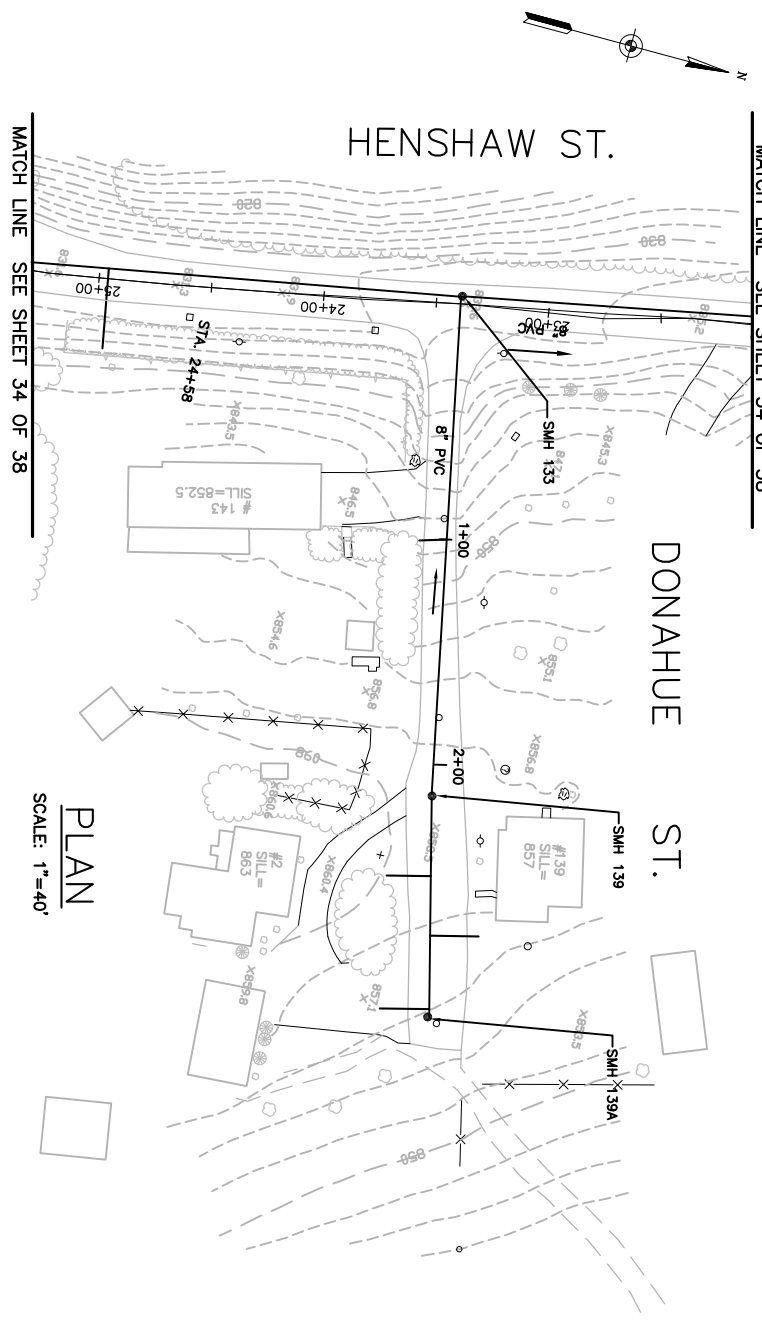

DATE: 08/07/01


**RECORD DRAWING**

I HEREBY CERTIFY THAT TO THE BEST OF MY KNOWLEDGE, BASED UPON CONSTRUCTION RECORDS PROVIDED BY THE RESIDENT ENGINEER AND THE CONTRACTOR, THIS DRAWING HAS BEEN COMPLETED AS SHOWN.

HOYLE, TANNER & ASSOCIATES, INC.

**NOTE:**

ALL PROJECT REQUIREMENTS AS SET FORTH ON THIS SHEET HAVE BEEN COMPLETED WITH DURING THE COURSE OF CONSTRUCTION. ALL NOTE WORDING CONTAINED HEREON IS UNDERSTOOD TO BE PAST TENSE.

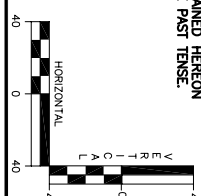

DRAWING NO. <b>35</b>	CHERRY VALLEY SEWER DISTRICT LEICESTER, MASSACHUSETTS		<b>Hoyle, Tanner &amp; Associates, Inc.</b> 150 Dow Street • Manchester • New Hampshire 03101 Consulting Engineers			PROJECT NO. 105709								
	GERTRUDE AVE. / DONAHUE ST.		SCALE: AS SHOWN	DATE: APRIL 2001	DES. BY JAH	DR. BY CAB/RCP	CHKD. BY NLT	FILE NAME ABPROF-35	DO NOT SCALE DRAWING	REV.	DESCRIPTION	DR. BY	CHKD. BY	APPD. BY
SHEET 35 OF 38										1. RECORD DRAWING				10/02