


PLAN
SCALE: 1"=20'

CROSS
ST.

NOTE:
CONNECT TO END OF EXISTING 8 INCH DUCTILE IRON WITH AN EIGHT INCH 90° BEND. REDUCE TO 6 INCH DUCTILE IRON TO TERMINATE WITH A EDDY F-260 HYDRANT WITH GATE AND BOX AS APPROVED BY WATER DISTRICT.

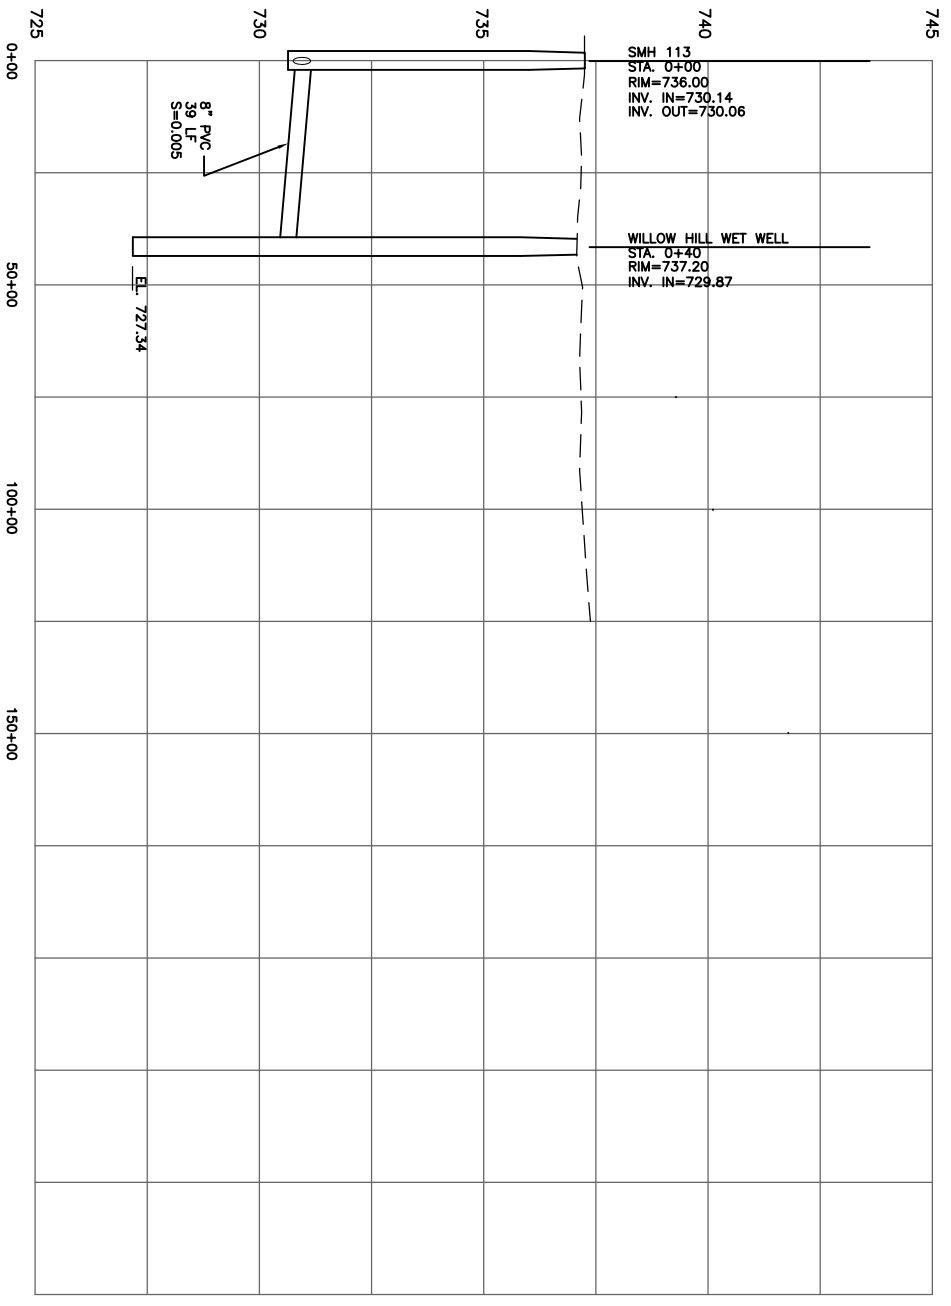

PROFILE
SCALE: 1"=20' HOR.
1"=2' VER.


'RECORD DRAWING'

I HEREBY CERTIFY THAT TO THE BEST OF MY KNOWLEDGE BASED UPON CONSTRUCTION RECORDS PROVIDED BY THE RESIDENT ENGINEER AND THE CONTRACTOR, ALL WORK SHOWN ON THIS DRAWING HAS BEEN COMPLETED AS SHOWN.

HOYLE, TANNER & ASSOCIATES, INC.

NOTE:

ALL PROJECT REQUIREMENTS AS SET FORTH ON THIS SHEET HAVE BEEN COMPLETED. THE COURSE OF CONSTRUCTION AT THE NOTE WORDING CONTAINED HEREON IS UNDERSTOOD TO BE PAST TENSE.

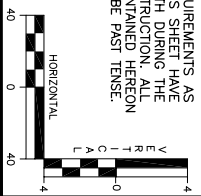

ENGINEER/ARCHITECT

PROJECT NO.	105710	FILE NAME	WILL-PSTA
DO NOT SCALE DRAWING	1. RECORD DRAWING	S.R.	W.C.
REV.	DESCRIPTION	CHKD. BY	W.C.
		APPD. BY	3/03
		DATE	

HTA Hoyle, Tanner & Associates, Inc.
150 Dow Street • Manchester • New Hampshire 03101
Consulting Engineers

SCALE: AS SHOWN	DATE: FEB. 2002	DES. BY JAH	DR. BY CAB	CHKD. BY NLT
-----------------	-----------------	-------------	------------	--------------

CHERRY VALLEY SEWER DISTRICT
LEICESTER, MASSACHUSETTS

PLAN AND PROFILE

WILLOW HILL PUMP STATION
GRAVITY SEWER LINE TO WET WELL