


# CHERRY VALLEY SEWER DISTRICT PHASE I

FOR  
LEICESTER, MASSACHUSETTS

APRIL, 2000

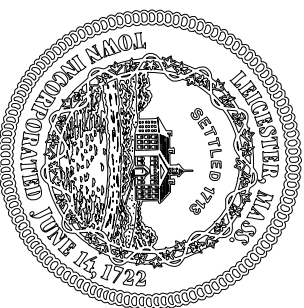

SEWER COMMISSIONERS

**VICTOR TAYLOR, Chairman**  
**MICHAEL DELLACAVA**  
**DONALD MANSÉAU**  
**MICHAEL KNOX, Clerk**

**PREPARED BY**  
**HOYLE, TANNER & ASSOCIATES, INC.**  
**CONSULTING ENGINEERS**  
**MANCHESTER, NEW HAMPSHIRE**

**'AS-BUILT'**

I HEREBY CERTIFY THAT TO THE BEST OF MY KNOWLEDGE, BASED UPON CONSTRUCTION RECORDS PROVIDED BY THE RESIDENT ENGINEER, ALL WORK SHOWN ON THIS DRAWING HAS BEEN COMPLETED AS SHOWN.

HOYLE, TANNER & ASSOCIATES, INC.

SIGNED \_\_\_\_\_

DATE \_\_\_\_\_