


CHERRY VALLEY SEWER DISTRICT PHASE II

FOR
LEICESTER, MASSACHUSETTS

APRIL, 2001

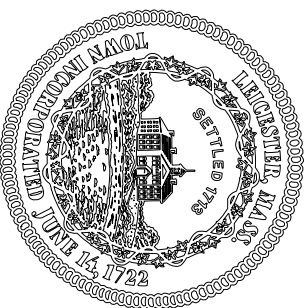

SEWER COMMISSIONERS

VICTOR TAYLOR, Chairman
MICHAEL DELLACAVA
DONALD MANSSEAU
MICHAEL KNOX, Clerk

PREPARED BY
HOYLE, TANNER & ASSOCIATES, INC.
CONSULTING ENGINEERS
MANCHESTER, NEW HAMPSHIRE

'RECORD DRAWING'

I HEREBY CERTIFY THAT TO THE BEST OF MY KNOWLEDGE BASED UPON CONSTRUCTION RECORDS PROVIDED BY THE RESIDENT ENGINEER AND THE CONTRACTOR, ALL WORK SHOWN ON THIS DRAWING HAS BEEN COMPLETED AS SHOWN.

HOYLE, TANNER & ASSOCIATES, INC.

NOTE:

ALL PROJECT REQUIREMENTS AS SET FORTH ON THIS SHEET HAVE BEEN COMPLIED WITH DURING THE COURSE OF CONSTRUCTION. ALL WORK SHOWN ON THIS DRAWING IS UNDERSTOOD TO BE PAST TENSE.