


CHERRY VALLEY SEWER DISTRICT

PHASE III

FOR

LEICESTER, MASSACHUSETTS

FEBRUARY, 2002

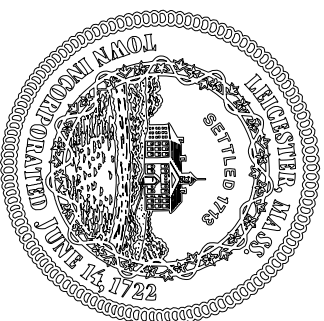

SEWER COMMISSIONERS

DONALD MANSSEAU, Chairman

MICHAEL DELLACAVA

VICTOR TAYLOR

MICHAEL KNOX, Clerk

PREPARED BY

HOYLE, TANNER & ASSOCIATES, INC.

CONSULTING ENGINEERS

MANCHESTER, NEW HAMPSHIRE

'RECORD DRAWING'

I HEREBY CERTIFY THAT TO THE BEST OF MY KNOWLEDGE, BASED UPON CONSTRUCTION RECORDS FROM THE FIELD, I AM AN ENGINEER AND THE CONTRACTOR'S ALL WORK SHOWN ON THIS DRAWING HAS BEEN COMPLETED AS SHOWN.

HOYLE, TANNER & ASSOCIATES, INC.

NOTE:

ALL PROJECT REQUIREMENTS AS SET FORTH ON THIS SHEET HAVE BEEN COMPLETED DURING THE COURSE OF CONSTRUCTION. ALL NOTE WORDS CONTAINED HEREON IS UNDERSTOOD TO BE PAST TENSE.