

MAIN ST. (ROUTE 9)


LOCUST STREET

PLAN
SCALE: 1"=40'


'AS-BUILT'

I HEREBY CERTIFY THAT TO THE BEST OF MY KNOWLEDGE AND BELIEF, THE INFORMATION BASED UPON CONSTRUCTION RECORDS PROVIDED BY THE RESIDENT ENGINEER AND THE CONTRACTOR, ALL WORK SHOWN ON THIS DRAWING HAS BEEN COMPLETED AS SHOWN.

HOYLE, TANNER & ASSOCIATES, INC.
SIGNED _____
DATE _____

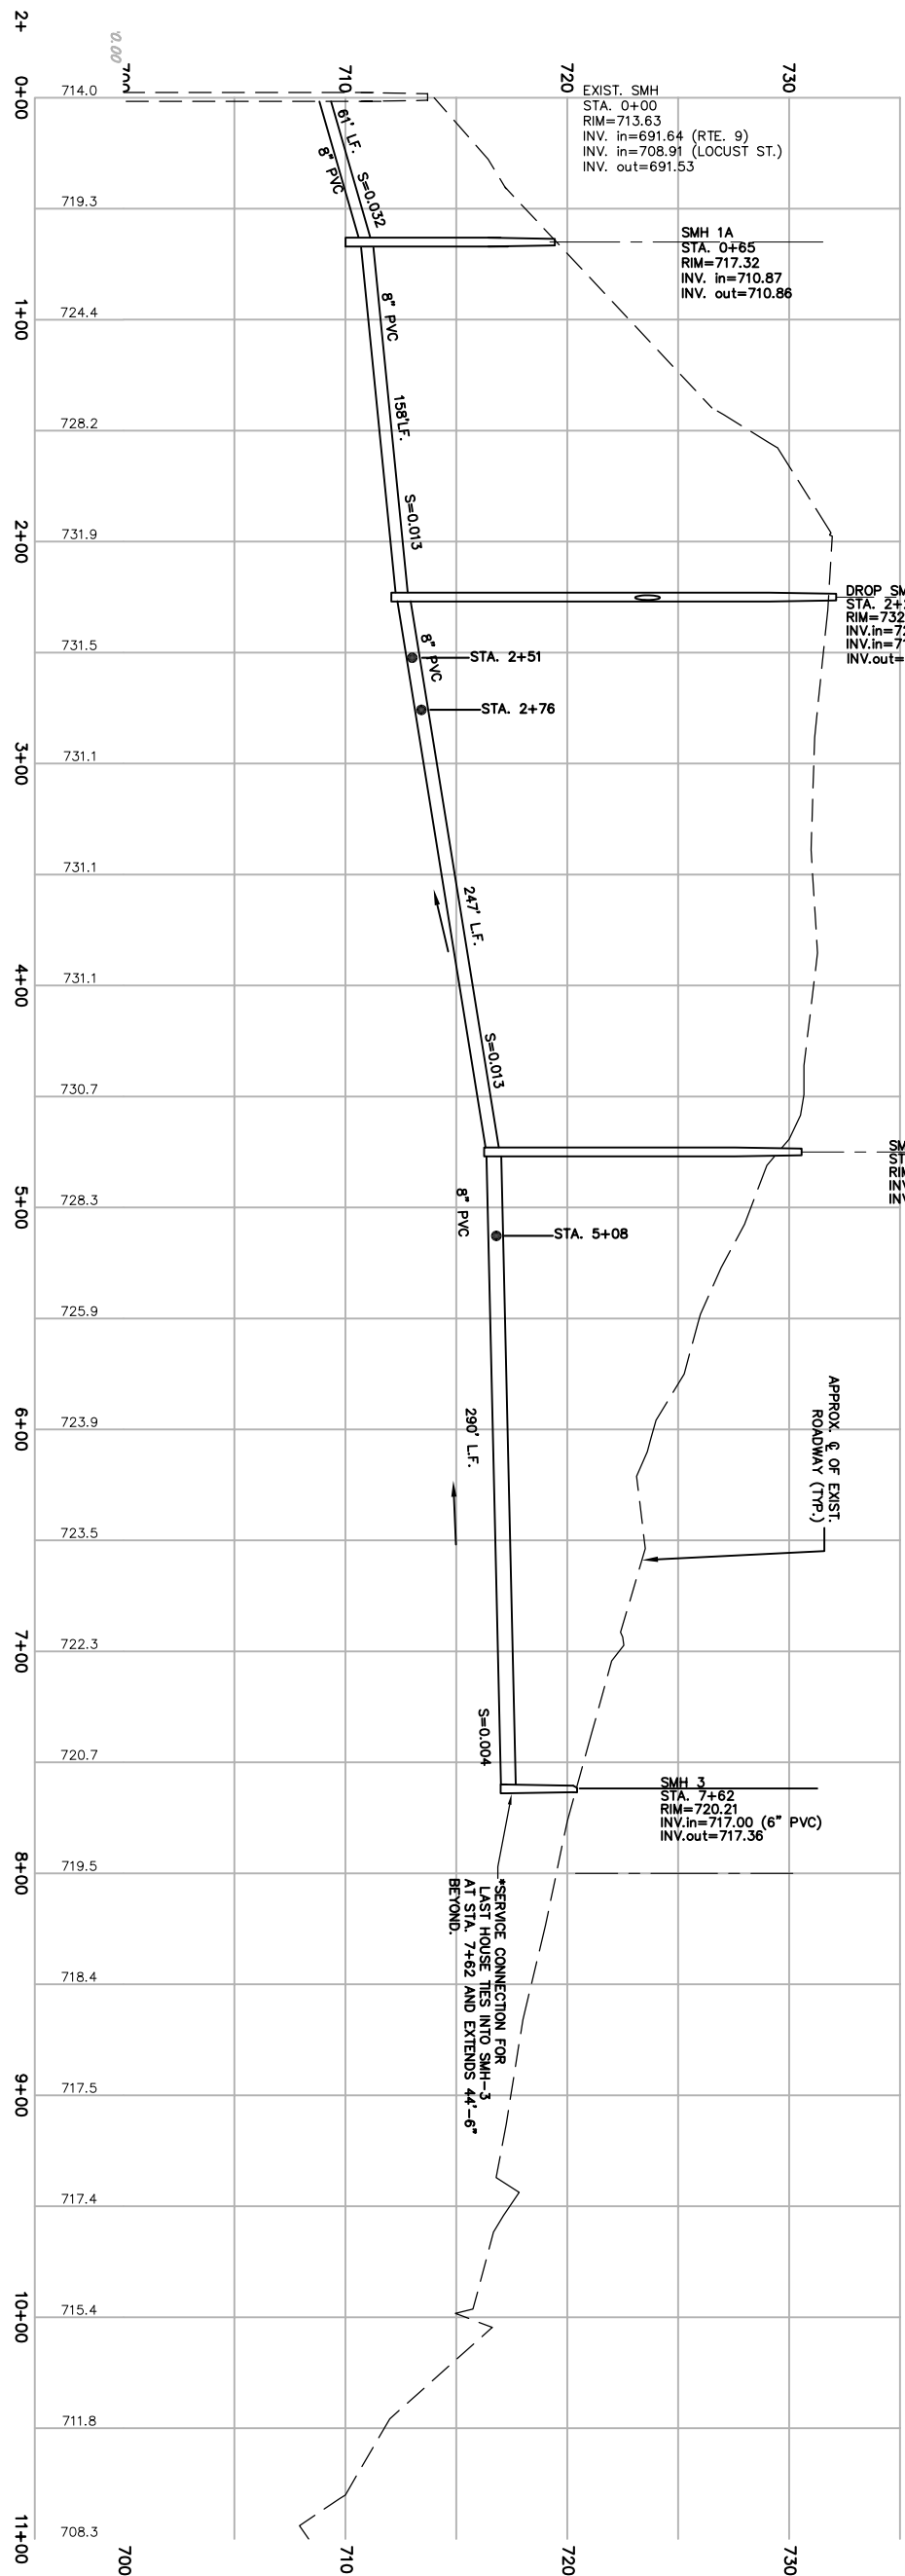

PROFILE
SCALE: 1"=40' HORIZ.
1"=4' VERT.

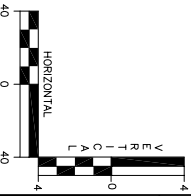

| | | | | | | | | | | | | | |
|-------------------------------|-------------------------|--|------------------|--|-----------------------|-------------------|----------------------|----------------------|-------------|--------------------|----------|----------|------|
| SHEET 2 OF 18 | DRAWING NO. 2 | CHERRY VALLEY SEWER DISTRICT LEICESTER, MASSACHUSETTS | | Hoyle, Tanner & Associates, Inc. 150 Dow Street • Manchester • New Hampshire 03101 Consulting Engineers | PROJECT NO. 105707 | | | | | ENGINEER/ARCHITECT | | | |
| | | PLAN AND PROFILE | | | FILE NAME AB105P19 | REV. 1. AS-BUILTS | | C.B. J.H. J.H. 10/00 | | | | | |
| LOCUST STREET 0+00 TO 8+00 | | SCALE: AS SHOWN | DATE: APRIL 2000 | DES. BY JAH | DR. BY RCP | CHKD. BY NLT | DO NOT SCALE DRAWING | REV. | DESCRIPTION | DR. BY | CHKD. BY | APPD. BY | DATE |