




PLAN  
SCALE: 1"=40'

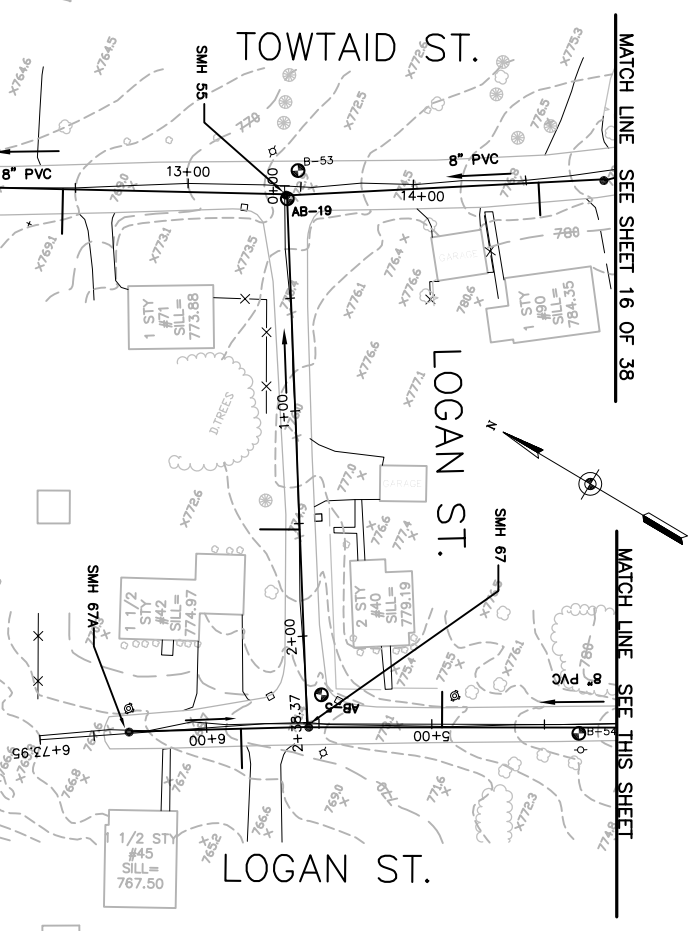

PLAN  
SCALE: 1"=40'

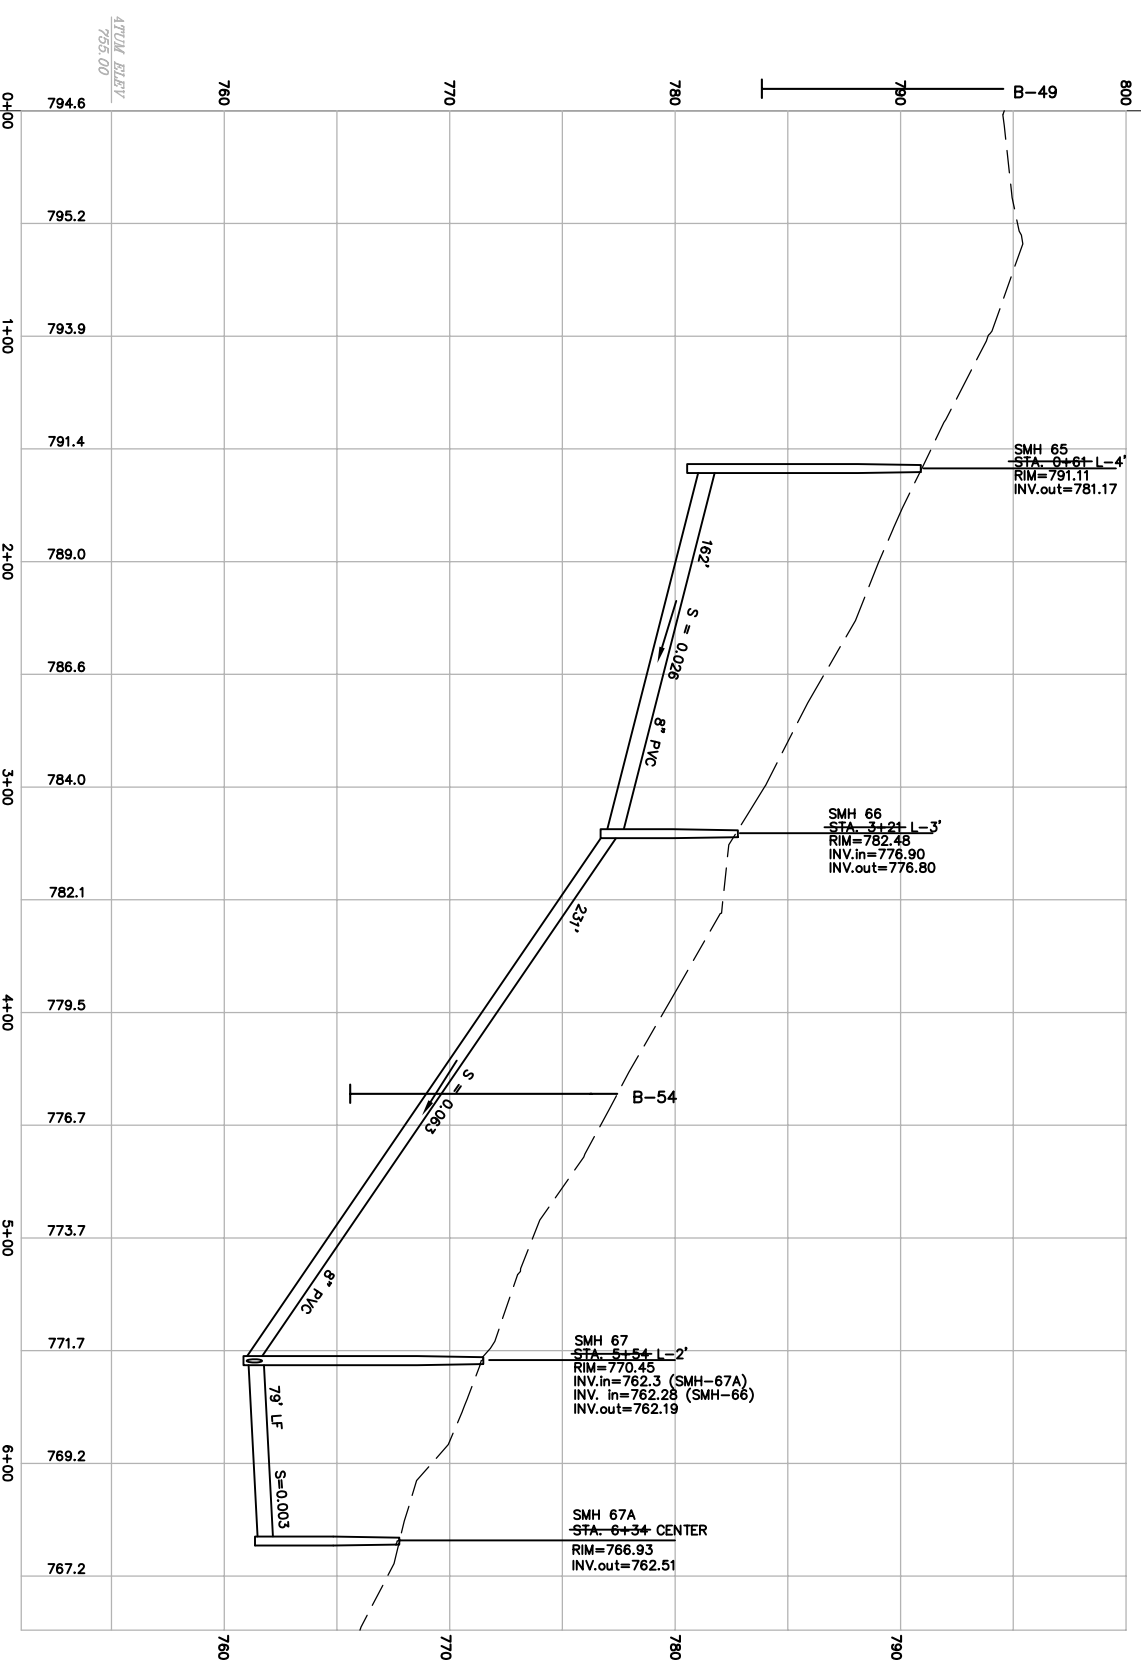

PROFILE  
SCALE: 1"=40' HORIZ.  
1"=4' VERT.

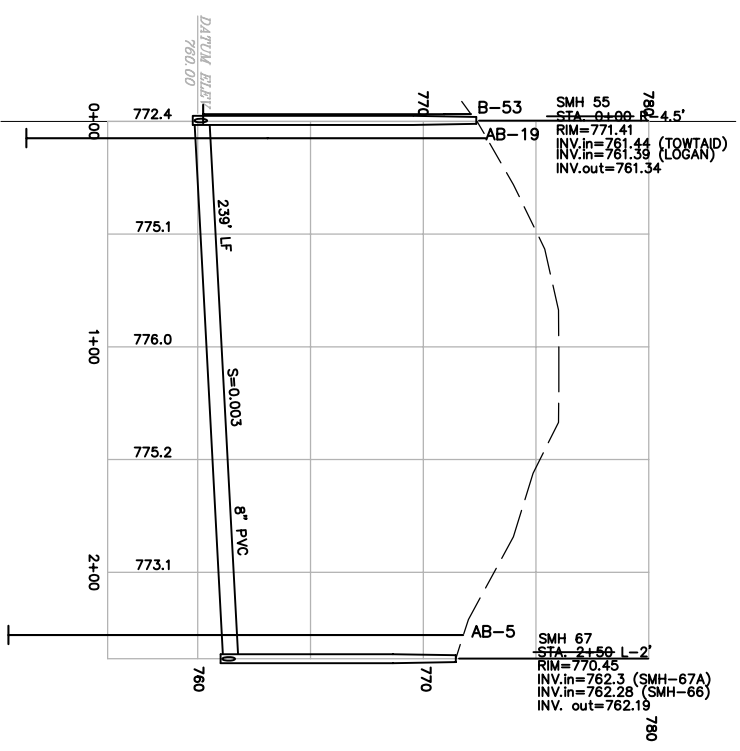

PROFILE  
SCALE: 1"=40' HORIZ.  
1"=4' VERT.

**RECORD DRAWING**

1. HERBERY GENTRY, THAT TO THE BEST OF HIS KNOWLEDGE, BASED UPON CONSTRUCTION RECORDS PROVIDED BY THE RESIDENT ENGINEER AND THE CONTRACTOR, ALL WORK SHOWN ON THIS DRAWING HAS BEEN COMPLETED AS SHOWN.

HOYLE, TANNER & ASSOCIATES, INC.

**NOTE:**  
ALL PROJECT REQUIREMENTS AS SET FORTH ON THIS SHEET HAVE BEEN COMPLETED WITH DURING THE CONSTRUCTION OF THIS PROJECT. THE NOTED WORKING CONDITIONS IS UNDERSTOOD TO BE PAST TENSE.

SHEET 18 OF 38	DRAWING NO. <b>18</b>	CHERRY VALLEY SEWER DISTRICT LEICESTER, MASSACHUSETTS	<b>Hoyle, Tanner &amp; Associates, Inc.</b> 150 Dow Street • Manchester • New Hampshire 03101 Consulting Engineers	PROJECT NO. 105709	ENGINEER/ARCHITECT DR. BY CHD. BY APP. BY DATE					
		PLAN AND PROFILE <b>LOGAN STREET</b>		FILE NAME ABPROF-18		1. RECORD DRAWING C.B. W.C. W.C. 10/02				
		SCALE: AS SHOWN	DATE: APRIL 2001	DES. BY JAH	DR. BY CAB/RCP	CHKD. BY NLT	DO NOT SCALE DRAWING	REV.	DESCRIPTION	DATE