

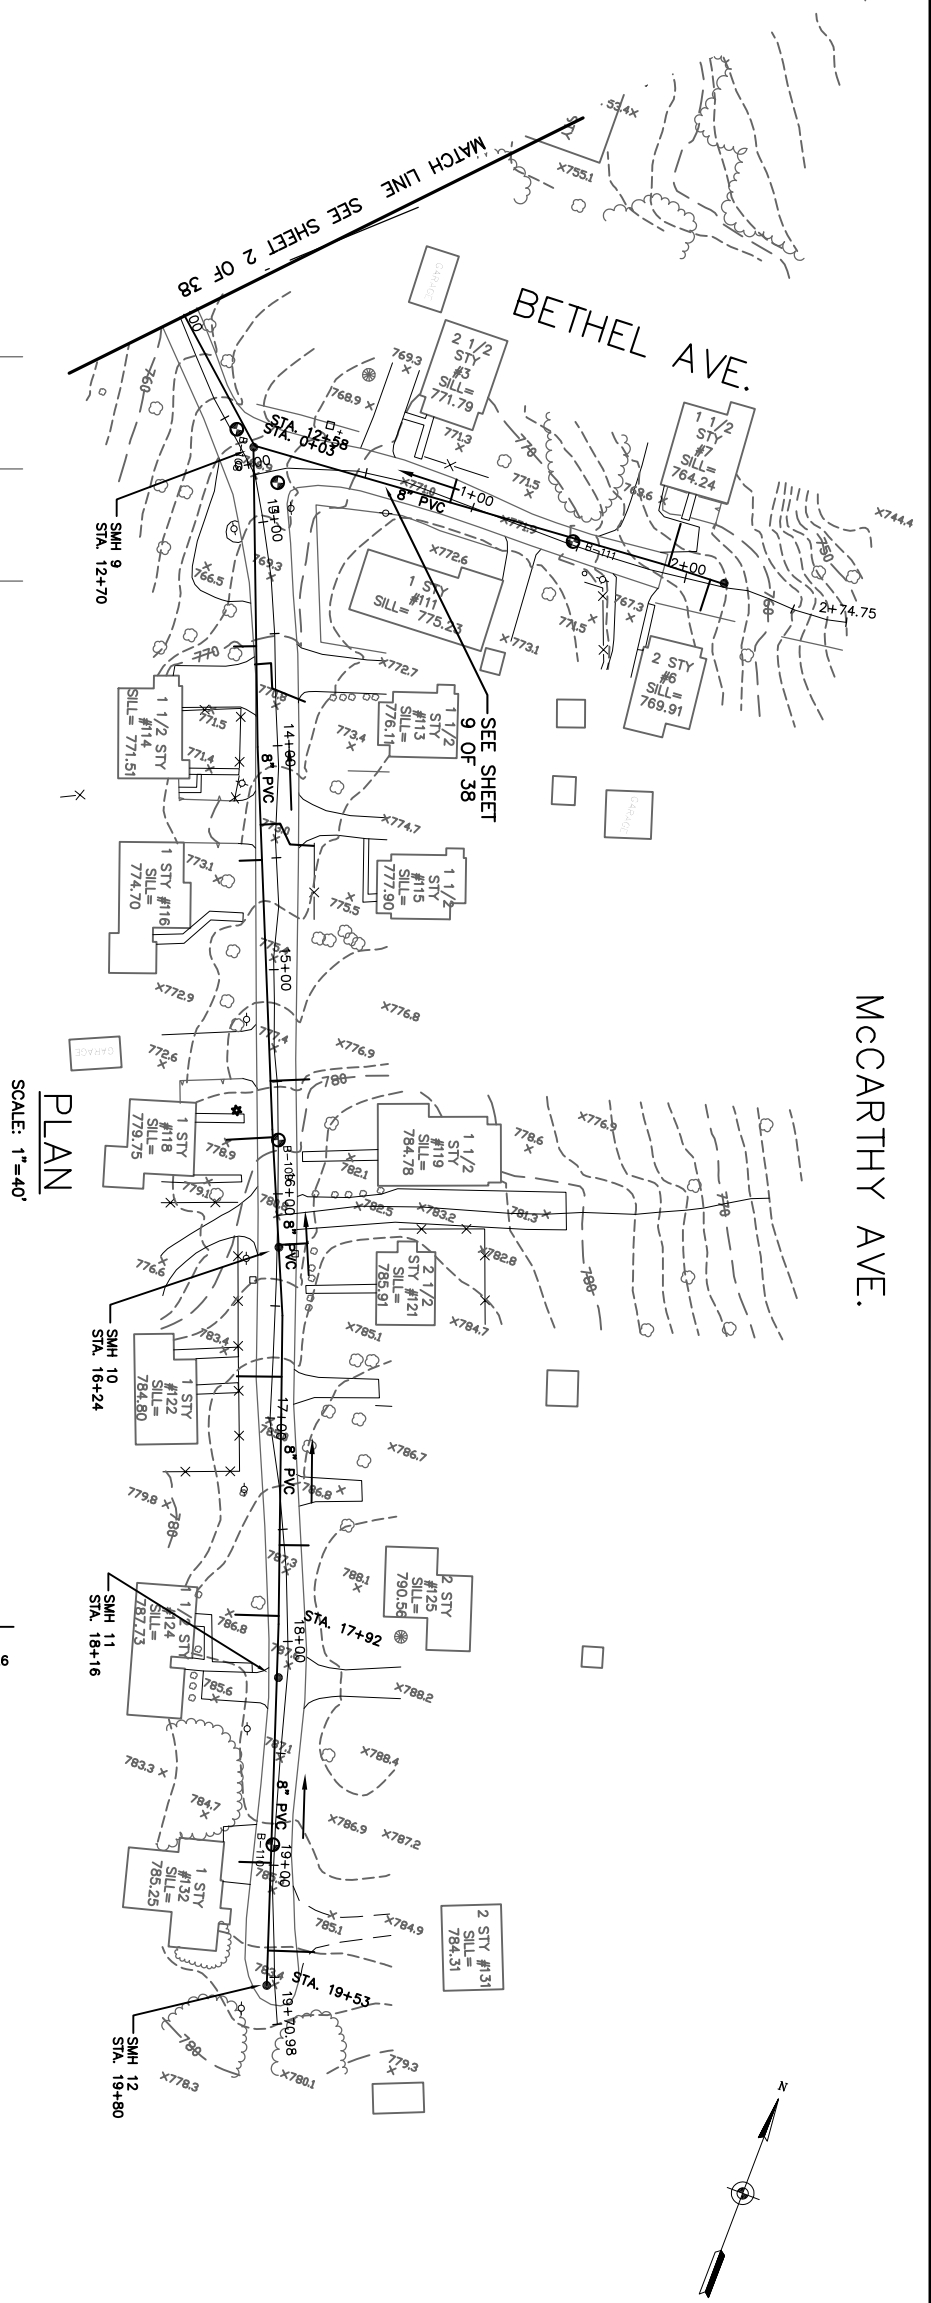


MCCARTHY AVE.

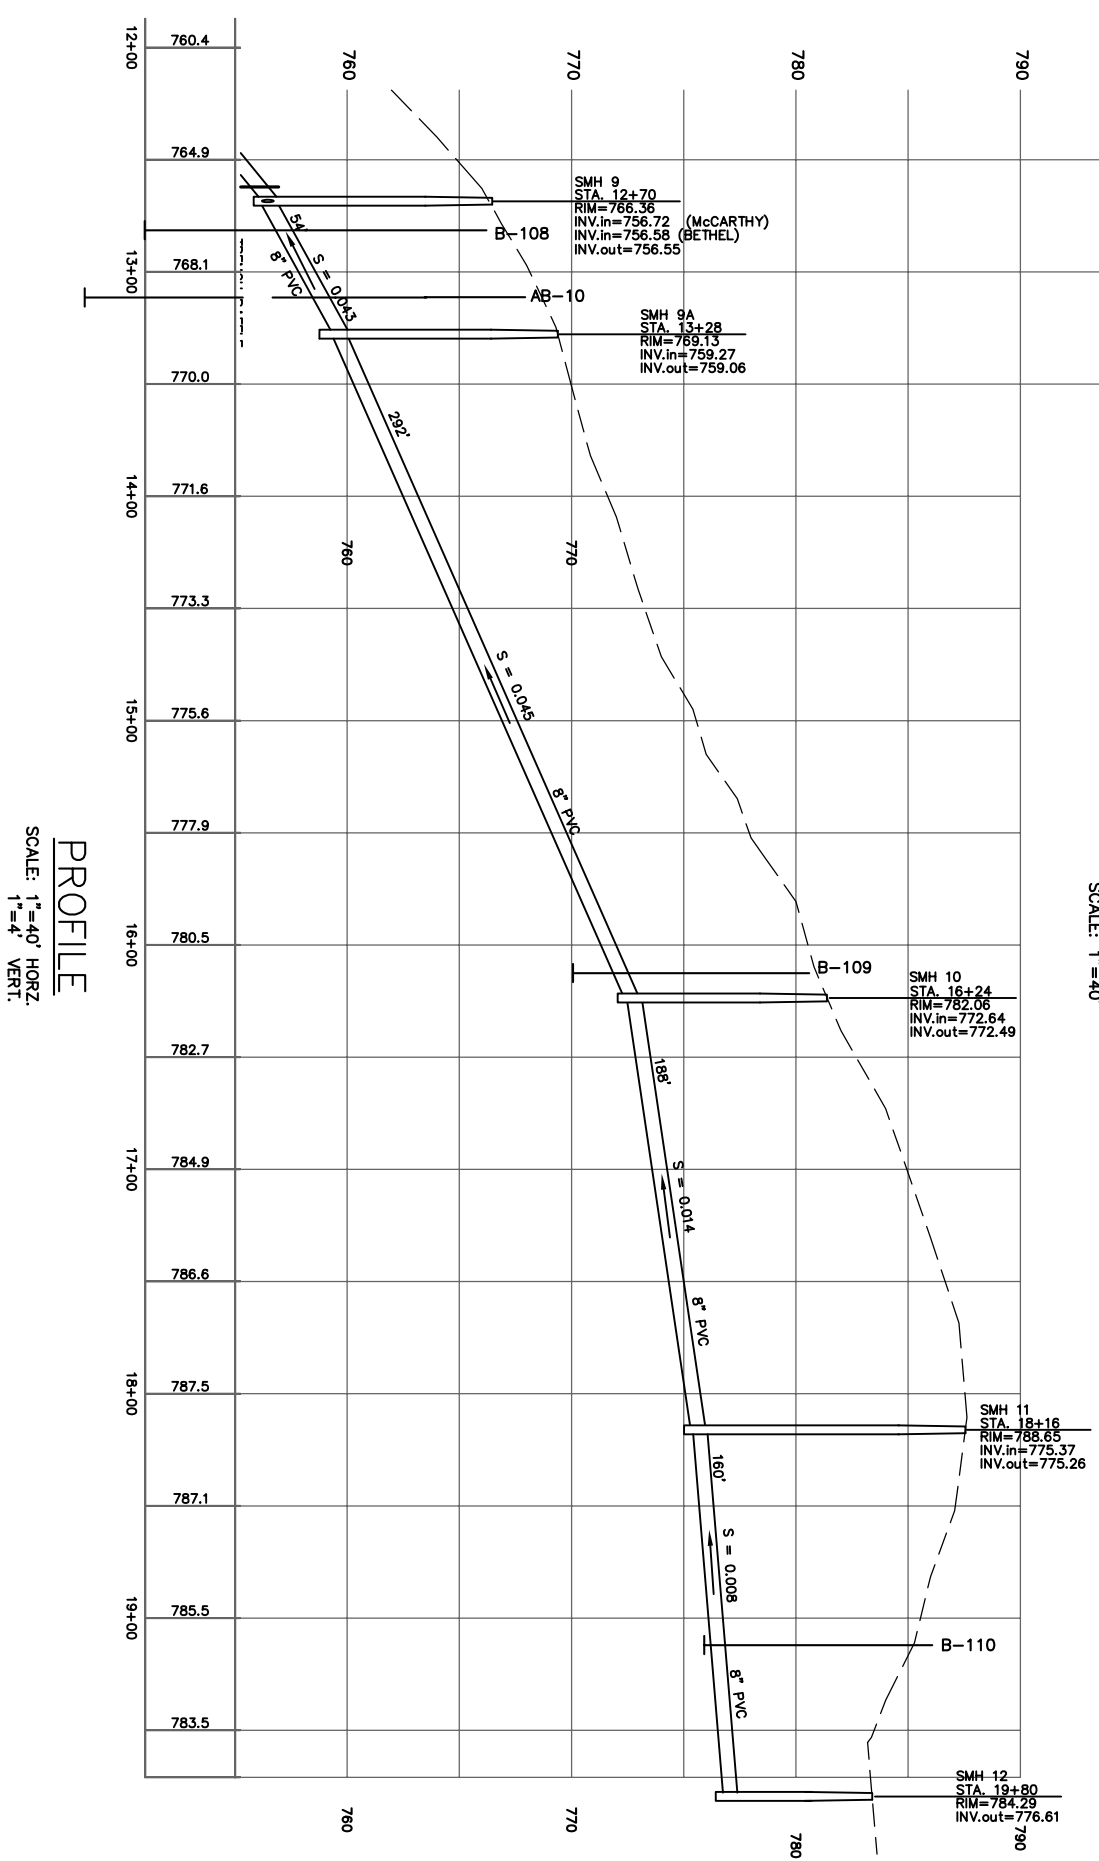

PLAN
SCALE: 1"=40'

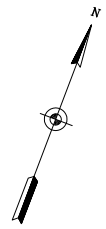

PROFILE
SCALE: 1"=40' HORIZ.
1"=4' VERT.


'RECORD DRAWING'

I HEREBY CERTIFY THAT TO THE BEST OF MY KNOWLEDGE BASED UPON CONSTRUCTION RECORDS PROVIDED BY THE RESIDENT, ENGINEER AND THE CONTRACTOR, ALL WORK SHOWN ON THIS DRAWING HAS BEEN COMPLETED AS SHOWN.

HOYLE, TANNER & ASSOCIATES, INC.

NOTE:

ALL PROJECT REQUIREMENTS AS SET FORTH ON THIS SHEET HAVE BEEN CONSIDERED AND CONSTRUCTION NOTE WORKING CONTAINED HEREON IS UNDERSTOOD TO BE PAST TENSE.

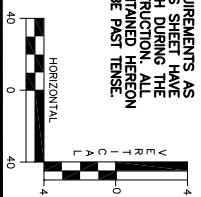

SHEET 3 OF 38	DRAWING NO. 3	CHERRY VALLEY SEWER DISTRICT LEICESTER, MASSACHUSETTS	Hoyle, Tanner & Associates, Inc. Consulting Engineers 150 Dow Street • Manchester • New Hampshire 03101	PROJECT NO. 105709	1. RECORD DRAWING C.B. W.C. W.C. 10/02	ENGINEER/ARCHITECT
		McCarthy Ave. 12+00 TO 19+53		FILE NAME ABPROF-03		
		SCALE: AS SHOWN	DATE: APRIL 2001	DES. BY JAH	DR. BY CAB/RCP	CHKD. BY NLT
				REV.	DESCRIPTION	DR. BY
						CHKD. BY
						APPRO. BY
						DATE