

1.	RECORD DRAWING	S.R.	W.C.	W.C.	3/03
REV.	DESCRIPTION	DR. BY	CHKD. BY	APPD. BY	DATE

PROJECT NO.	105710
FILE NAME	PLAY--McCAR
DO NOT SCALE DRAWING	


**HTA** Hoyle, Tanner & Associates, Inc.  
150 Dow Street • Manchester • New Hampshire 03101  
Consulting Engineers

SCALE: AS SHOWN	DATE: FEB. 2002	DES. BY JAH	DR. BY CAB	CHKD. BY NLT
-----------------	-----------------	----------------	---------------	-----------------


CHERRY VALLEY SEWER DISTRICT  
LEICESTER, MASSACHUSETTS  
PLAN AND PROFILE

**McCARTHY AVE.**  
PUMP LAYOUT

ITEM	DESCRIPTION	MATERIAL & SIZE
1	PUMP	CAST IRON T4A-B
2	MOTOR	CAST IRON
3	ENGINE (WISCONSIN) MODEL	CAST IRON
4	DISCHARGE CHECK VALVE	CAST IRON
5	DISCHARGE PLUG VALVE	CAST IRON 3-WAY
6	AIR RELEASE VALVE	CAST IRON 1" (SHIPPED LOOSE)
7	DISCHARGE ELBOW 90°	CAST IRON
8	BELT GUARD ASSY	STEEL
9	PUMP & MOTOR BASE ASSY	STEEL

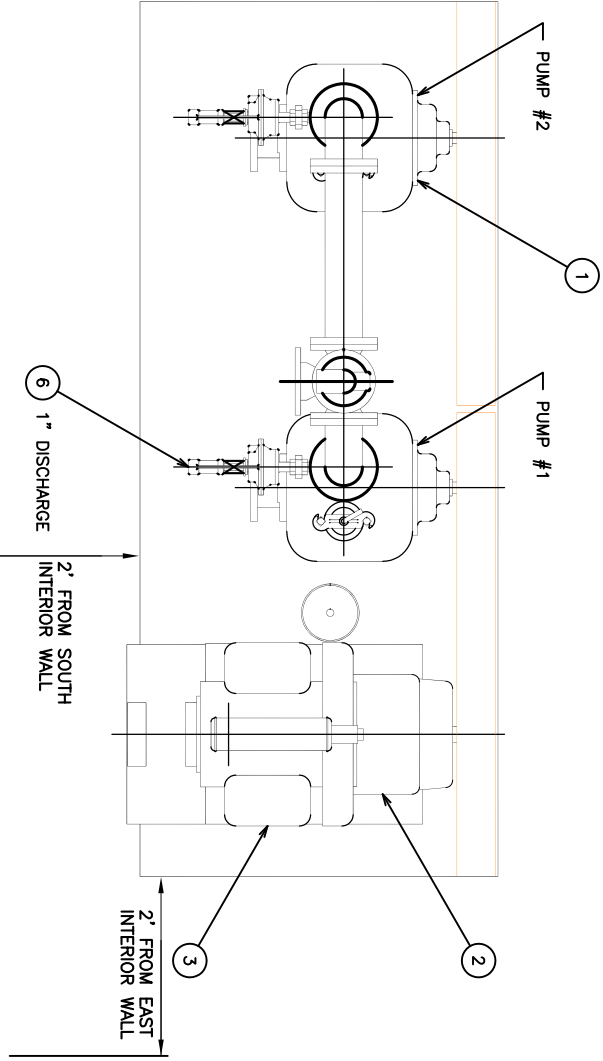

CENTER DISCHARGE				
PLUMBING SUCT. DISCH.	HDR.	A	B	C
4"	4"	49"	62 5/8"	50 3/4"
4"	4"	6"	50 1/2"	65 3/8"
4"	6"	6"	63 3/8"	78 1/4"
4"	6"	6"	63 3/8"	78 1/4"

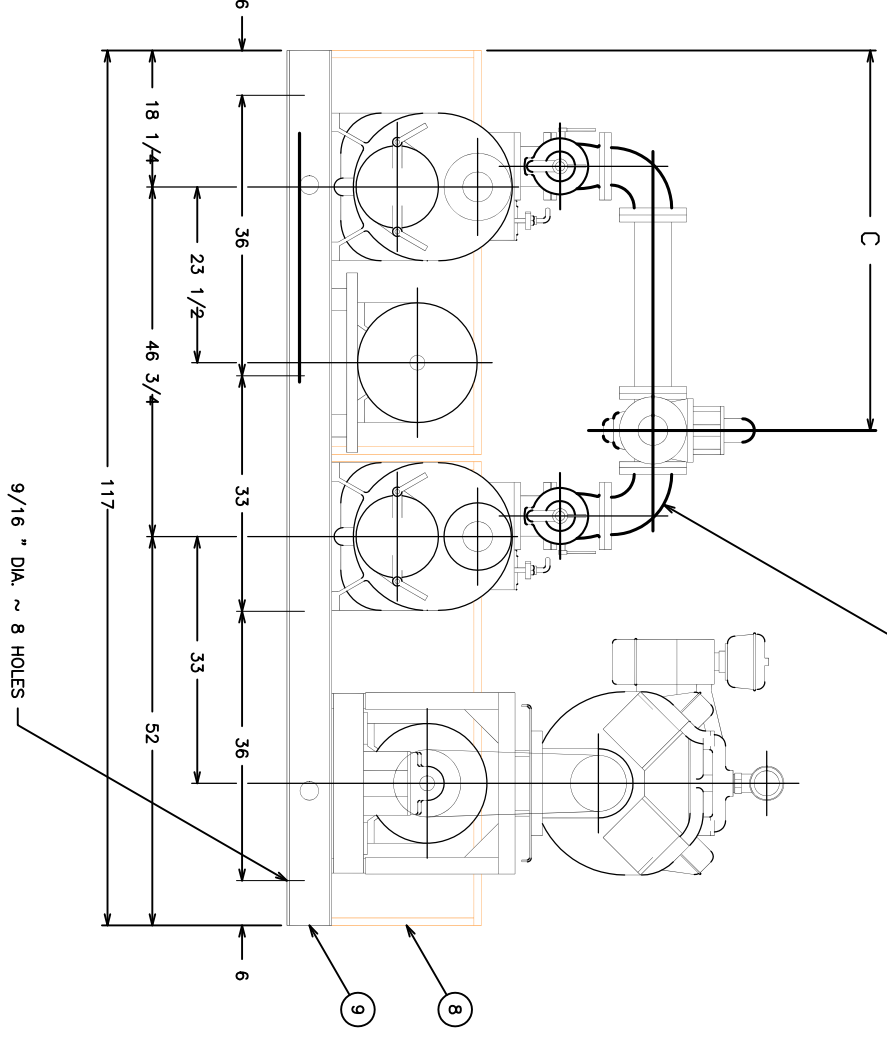


STANDBY PUMP UNIT  
RIGHT HAND DRIVE UNIT  
T4A-B, 4" X 4" X 4"  
AS SHOWN

**'RECORD DRAWING'**  
I HEREBY CERTIFY THAT TO THE BEST OF MY KNOWLEDGE, BASED UPON CONSTRUCTION RECORDS PROVIDED BY THE RESIDENT, ENGINEER AND THE CONTRACTOR, ALL WORK SHOWN ON THIS DRAWING HAS BEEN COMPLETED AS SHOWN.  
HOYLE, TANNER & ASSOCIATES, INC.

NOTE:  
ALL PROJECT REQUIREMENTS AS SET FORTH IN THIS SHEET HAVE BEEN COMPLIED WITH DURING THE COURSE OF CONSTRUCTION. ALL NOTE WORDING CONTAINED HEREON IS UNDERSTOOD TO BE PAST TENSE.

SCALE: 1" = 1'-0"

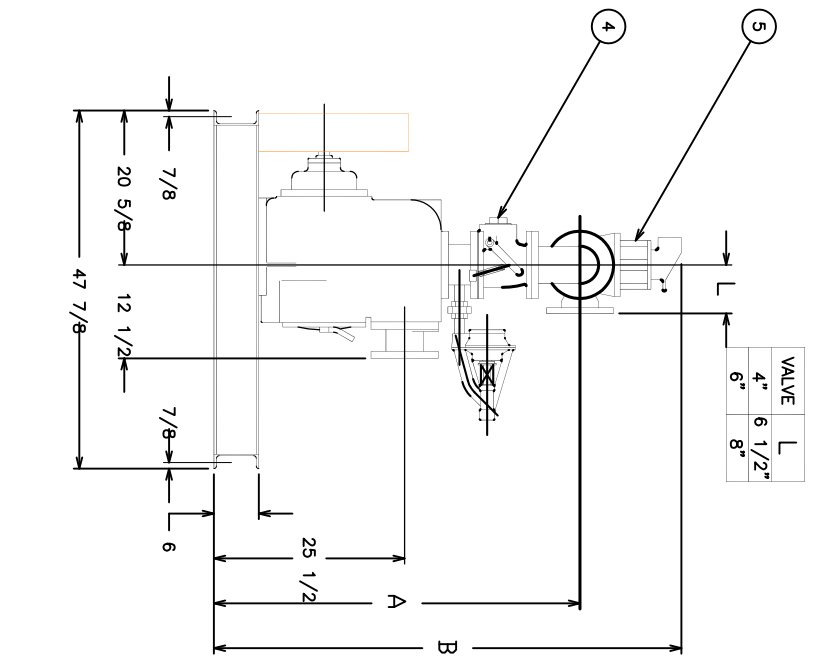

VALVE	L
4"	6 1/2"
6"	8"