



# RESERVOIR STREET

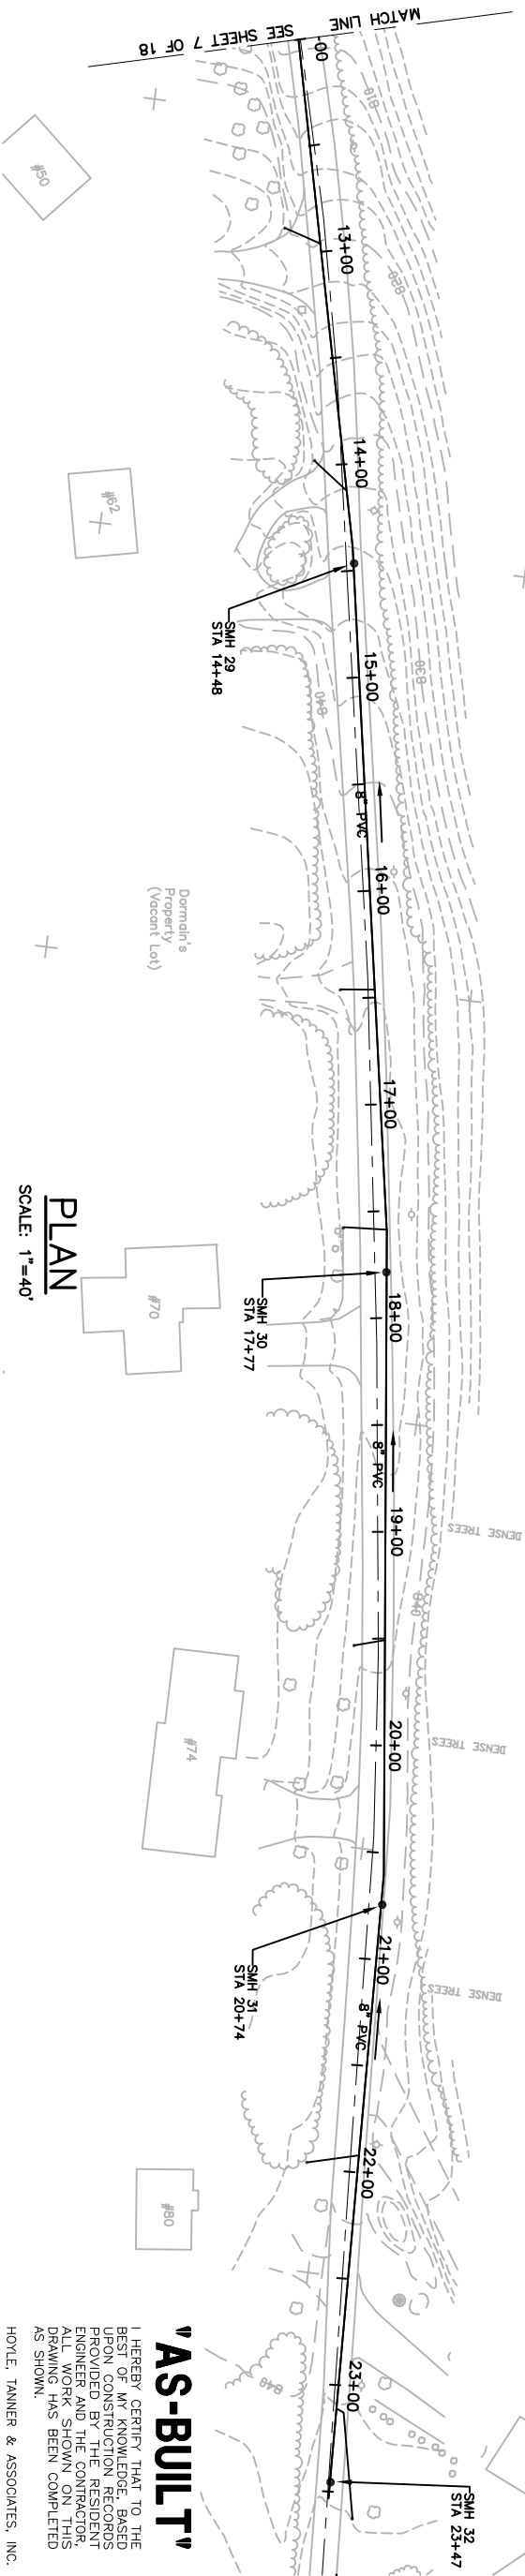


**PLAN**  
SCALE: 1"=40'

**'AS-BUILT'**  
I HEREBY CERTIFY THAT TO THE BEST OF MY KNOWLEDGE, BASED UPON CONSTRUCTION RECORDS PROVIDED BY THE RESIDENT ENGINEER AND THE CONTRACTOR, THIS DRAWING HAS BEEN COMPLETED AS SHOWN.  
HOYLE, TANNER & ASSOCIATES, INC.  
SIGNED \_\_\_\_\_  
DATE \_\_\_\_\_

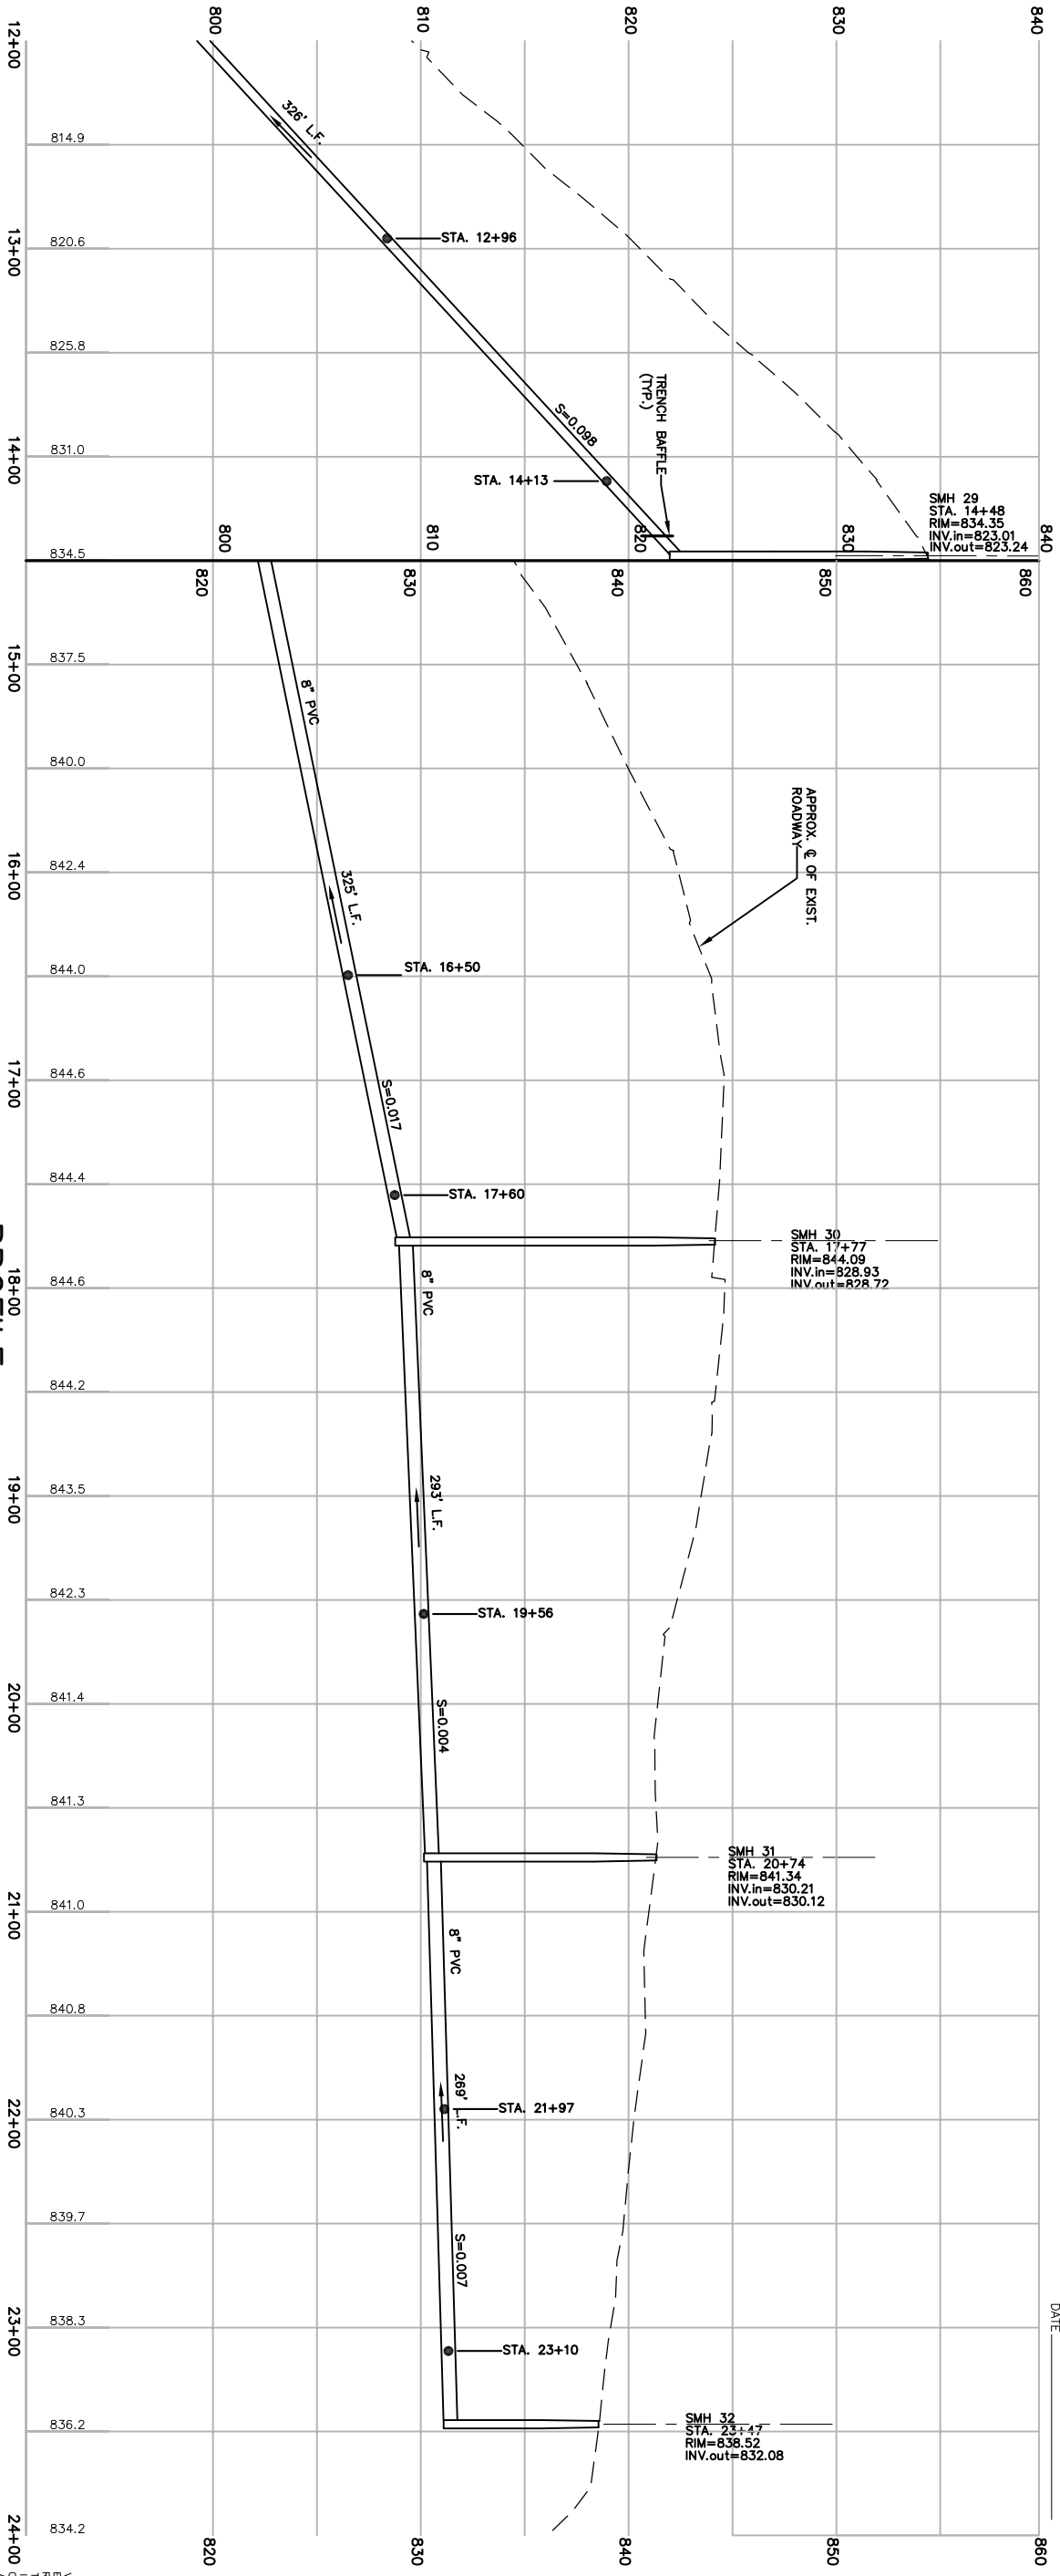

**PROFILE**  
SCALE: 1"=40' HORIZ.  
1"=4' VERT.

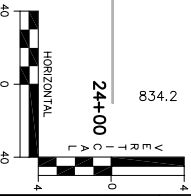

CHERRY VALLEY SEWER DISTRICT LEICESTER, MASSACHUSETTS PLAN AND PROFILE <b>RESERVOIR STREET</b> 12+00 TO 24+00	<b>Hoyle, Tanner &amp; Associates, Inc.</b> 150 Dow Street • Manchester • New Hampshire 03101 Consulting Engineers	PROJECT NO.	105707				
		FILE NAME	AB105P06				
DRAWING NO. <b>8</b>	SCALE: AS SHOWN DATE: APRIL 2000	DES. BY	JAH	DR. BY	RCP	CHKD. BY	NLT
		DO NOT SCALE DRAWING	REV.	DESCRIPTION	DR. BY	CHKD. BY	APPD. BY
			1.	AS-BUILTS	C.B.	J.H.	J.H. 10/00