




PLAN
SCALE: 1"=40'

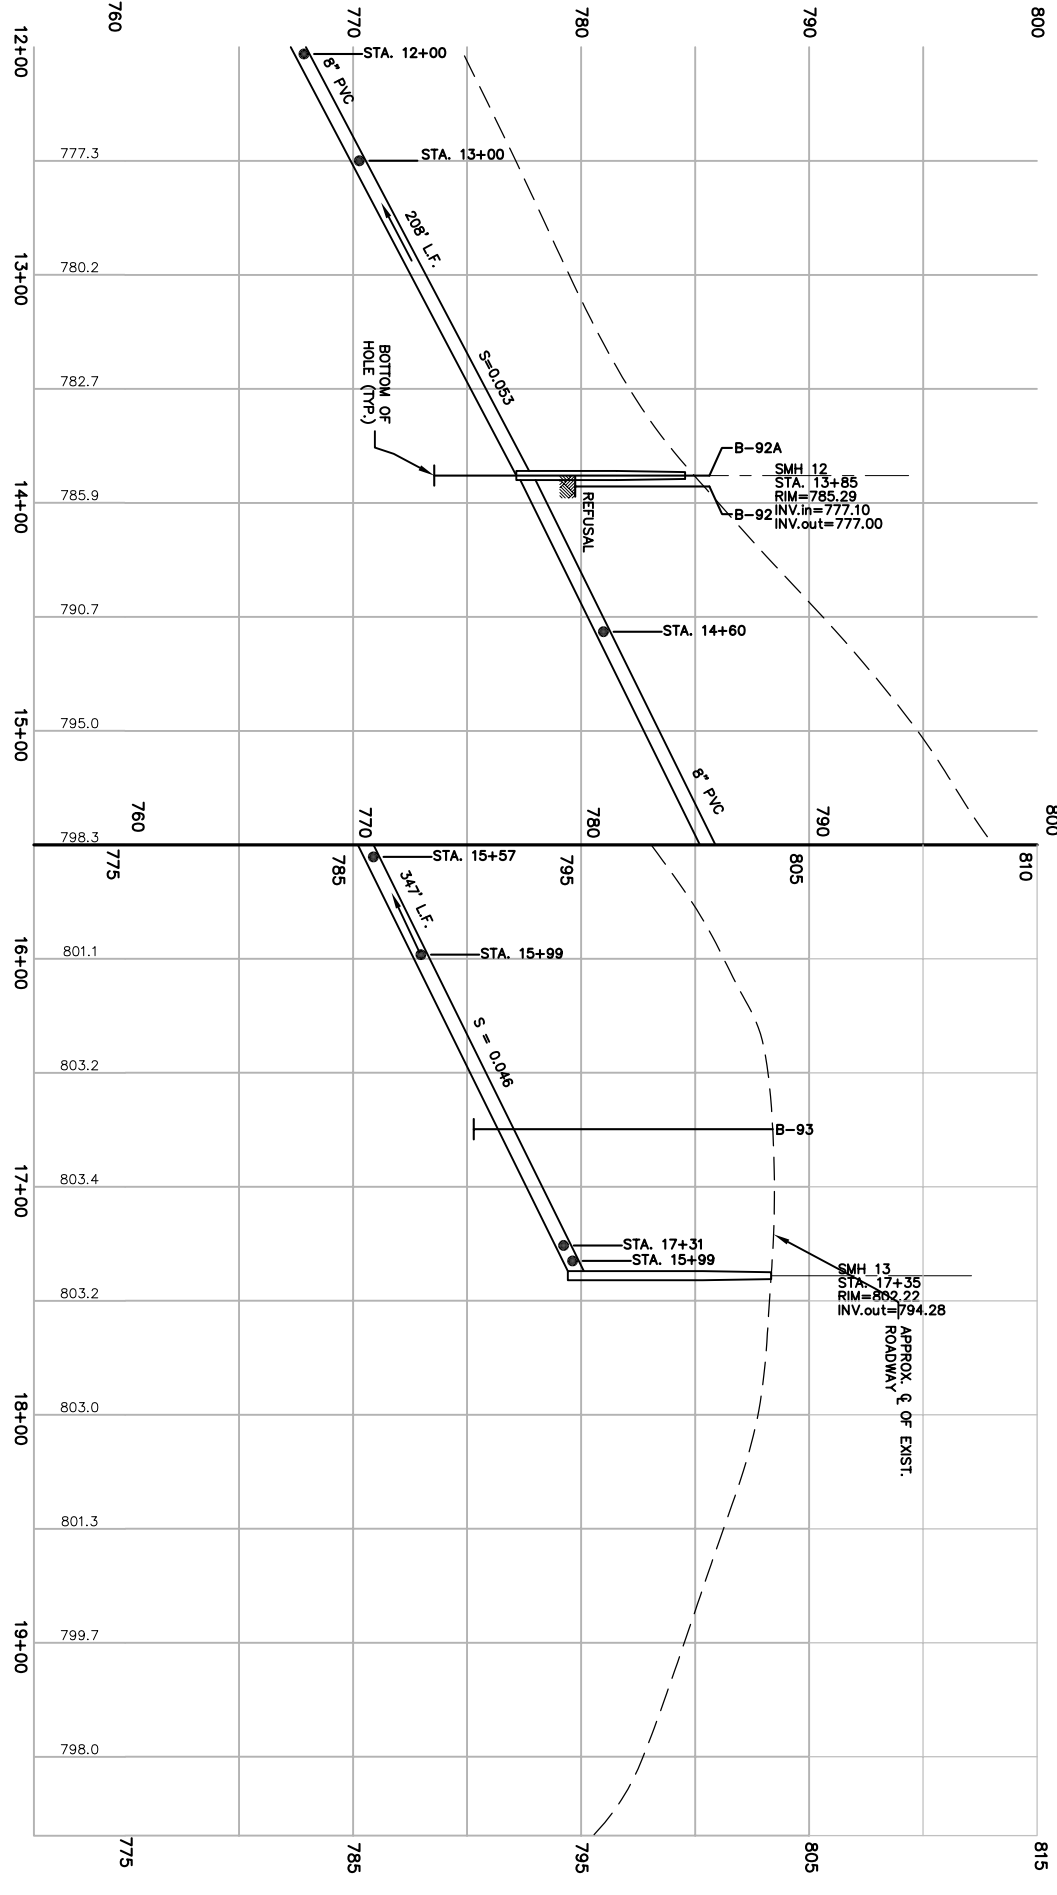

PROFILE
SCALE: 1"=40' HORZ.
1"=4' VERT.

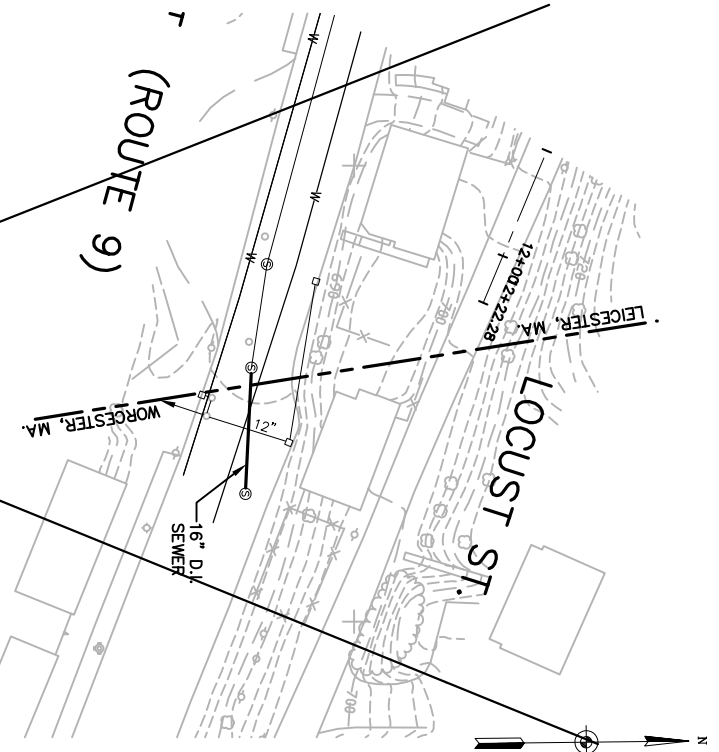

PLAN
SCALE: 1"=40'

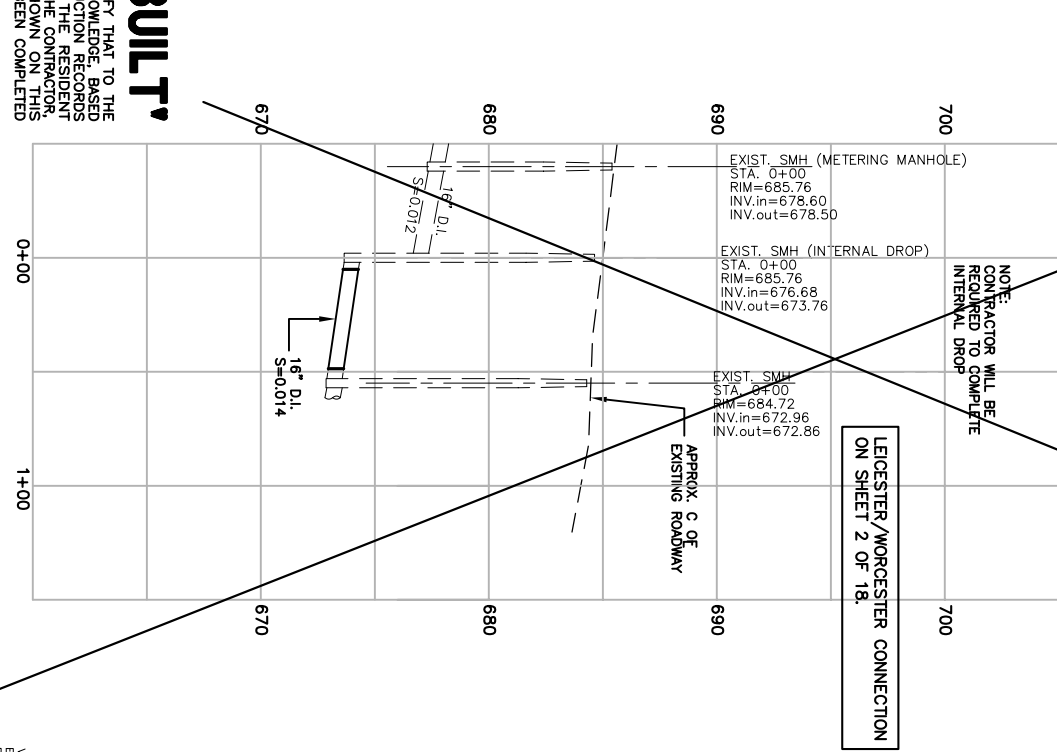


PROFILE
SCALE: 1"=40' HORZ.
1"=4' VERT.

'AS-BUILT'

I HEREBY CERTIFY THAT TO THE BEST OF MY KNOWLEDGE, BASED UPON CONSTRUCTION RECORDS PROVIDED BY THE RESIDENT ENGINEER AND THE CONDITIONS AS SHOWN, THE CONSTRUCTION DRAWING HAS BEEN COMPLETED AS SHOWN.

HOYLE, TANNER & ASSOCIATES, INC.
SIGNED _____
DATE _____

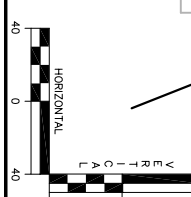

DRAWING NO. 4	CHERRY VALLEY SEWER DISTRICT LEICESTER, MASSACHUSETTS PLAN AND PROFILE		Hoyle, Tanner & Associates, Inc. 150 Dow Street • Manchester • New Hampshire 03101 Consulting Engineers	PROJECT NO. 105707	ENGINEER/ARCHITECT C.B. J.H. J.H. 10/00 DR. BY CHD. BY APPD. BY DATE	
	SARGENT ST./MAIN ST. (RTE. 9) 12+00 TO 19+76			FILE NAME AB105P02		1. AS-BUILTS REV. DESCRIPTION
SHEET 4 OF 18	SCALE: AS SHOWN	DATE: APRIL 2000	DES. BY JAH	DR. BY RCP	CHKD. BY NLT	DO NOT SCALE DRAWING