



PLAN
SCALE: 1"=40'

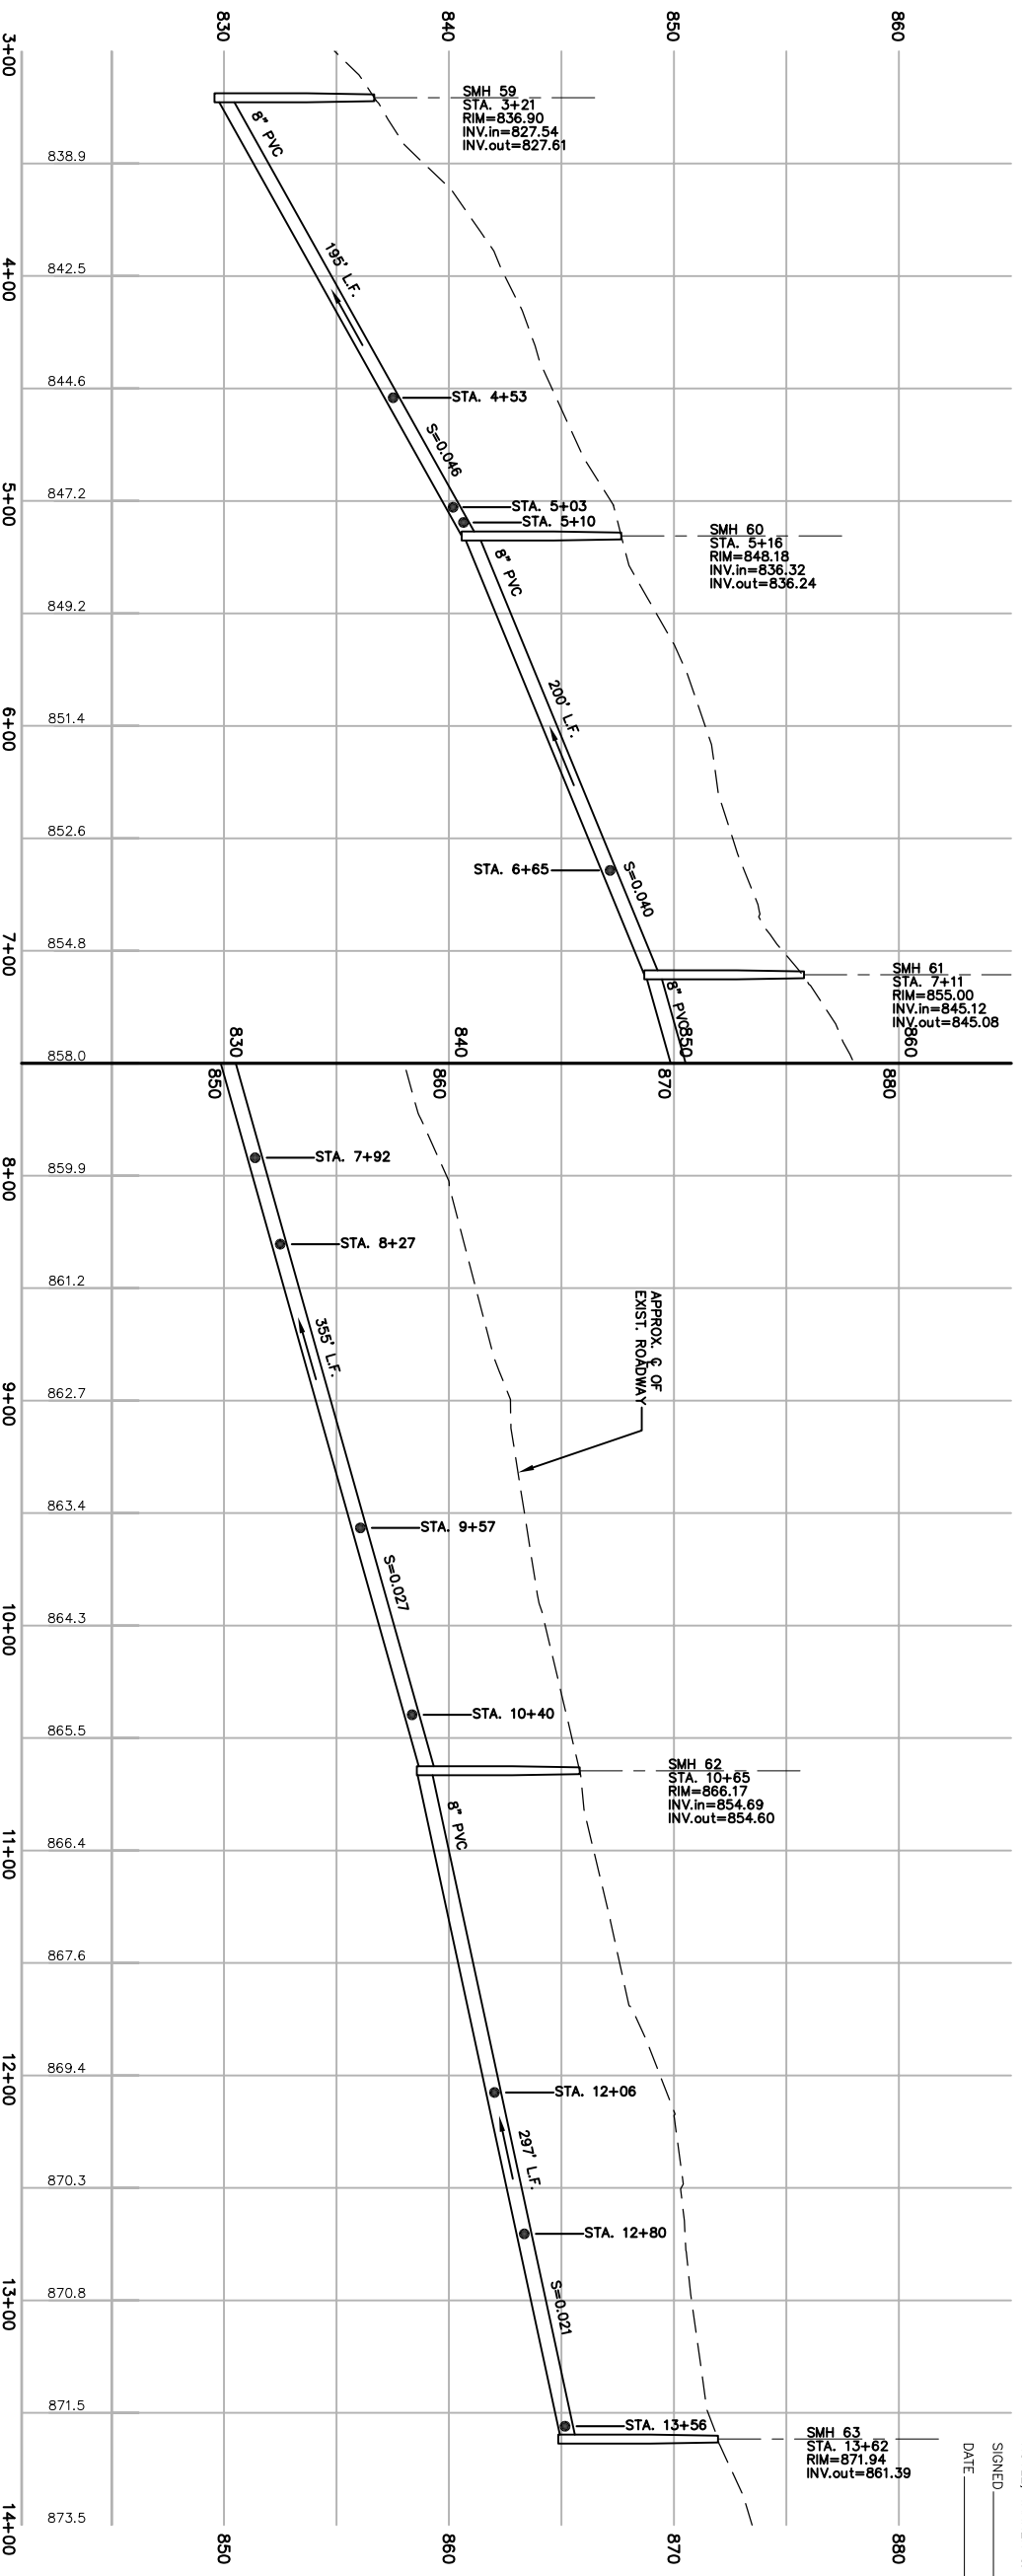

PROFILE
SCALE: 1"=40' HORZ.
1"=4' VERT.

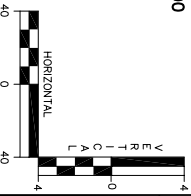

'AS-BUILT'

I HEREBY CERTIFY THAT TO THE BEST OF MY KNOWLEDGE BASED UPON CONSTRUCTION RECORDS PROVIDED BY THE RESIDENT ENGINEER AND THE CONTRACTOR, ALL WORK SHOWN ON THIS DRAWING HAS BEEN COMPLETED AS SHOWN.

HOYLE, TANNER & ASSOCIATES, INC.
SIGNED: _____
DATE: _____

SHEET 15 OF 18	DRAWING NO. 15	CHERRY VALLEY SEWER DISTRICT LEICESTER, MASSACHUSETTS PLAN AND PROFILE	Hoyle, Tanner & Associates, Inc. 150 Dow Street • Manchester • New Hampshire 03101 Consulting Engineers	PROJECT NO.	105707	ENGINEER/ARCHITECT												
				FILE NAME	AB105P14													
SCALE: AS SHOWN				DATE: APRIL 2000	DES. BY JAH	DR. BY RCP												
				CHKD. BY NLT	DO NOT SCALE DRAWING	<table border="1"> <tr> <td>1.</td> <td>AS-BUILTS</td> <td>C.B.</td> <td>J.H.</td> <td>J.H.</td> <td>10/00</td> </tr> <tr> <td>REV.</td> <td>DESCRIPTION</td> <td>DR. BY</td> <td>CHKD. BY</td> <td>APPD. BY</td> <td>DATE</td> </tr> </table>	1.	AS-BUILTS	C.B.	J.H.	J.H.	10/00	REV.	DESCRIPTION	DR. BY	CHKD. BY	APPD. BY	DATE
1.	AS-BUILTS	C.B.	J.H.	J.H.	10/00													
REV.	DESCRIPTION	DR. BY	CHKD. BY	APPD. BY	DATE													