



MATCH LINE SEE SHEET 18 OF 38

MATCH LINE SEE SHEET 16 OF 38

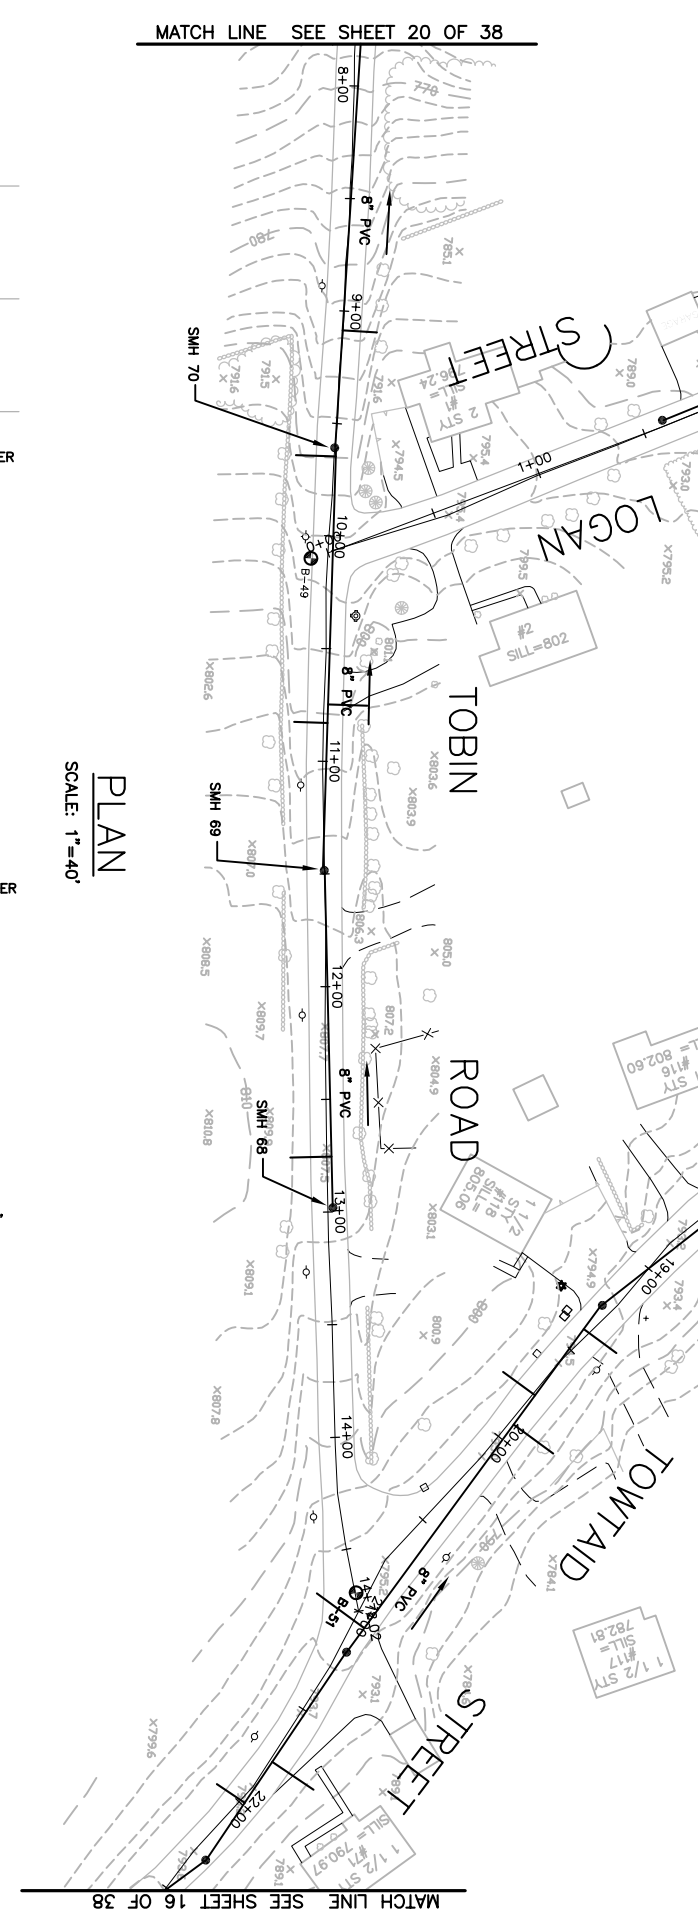

PLAN
SCALE: 1"=40'

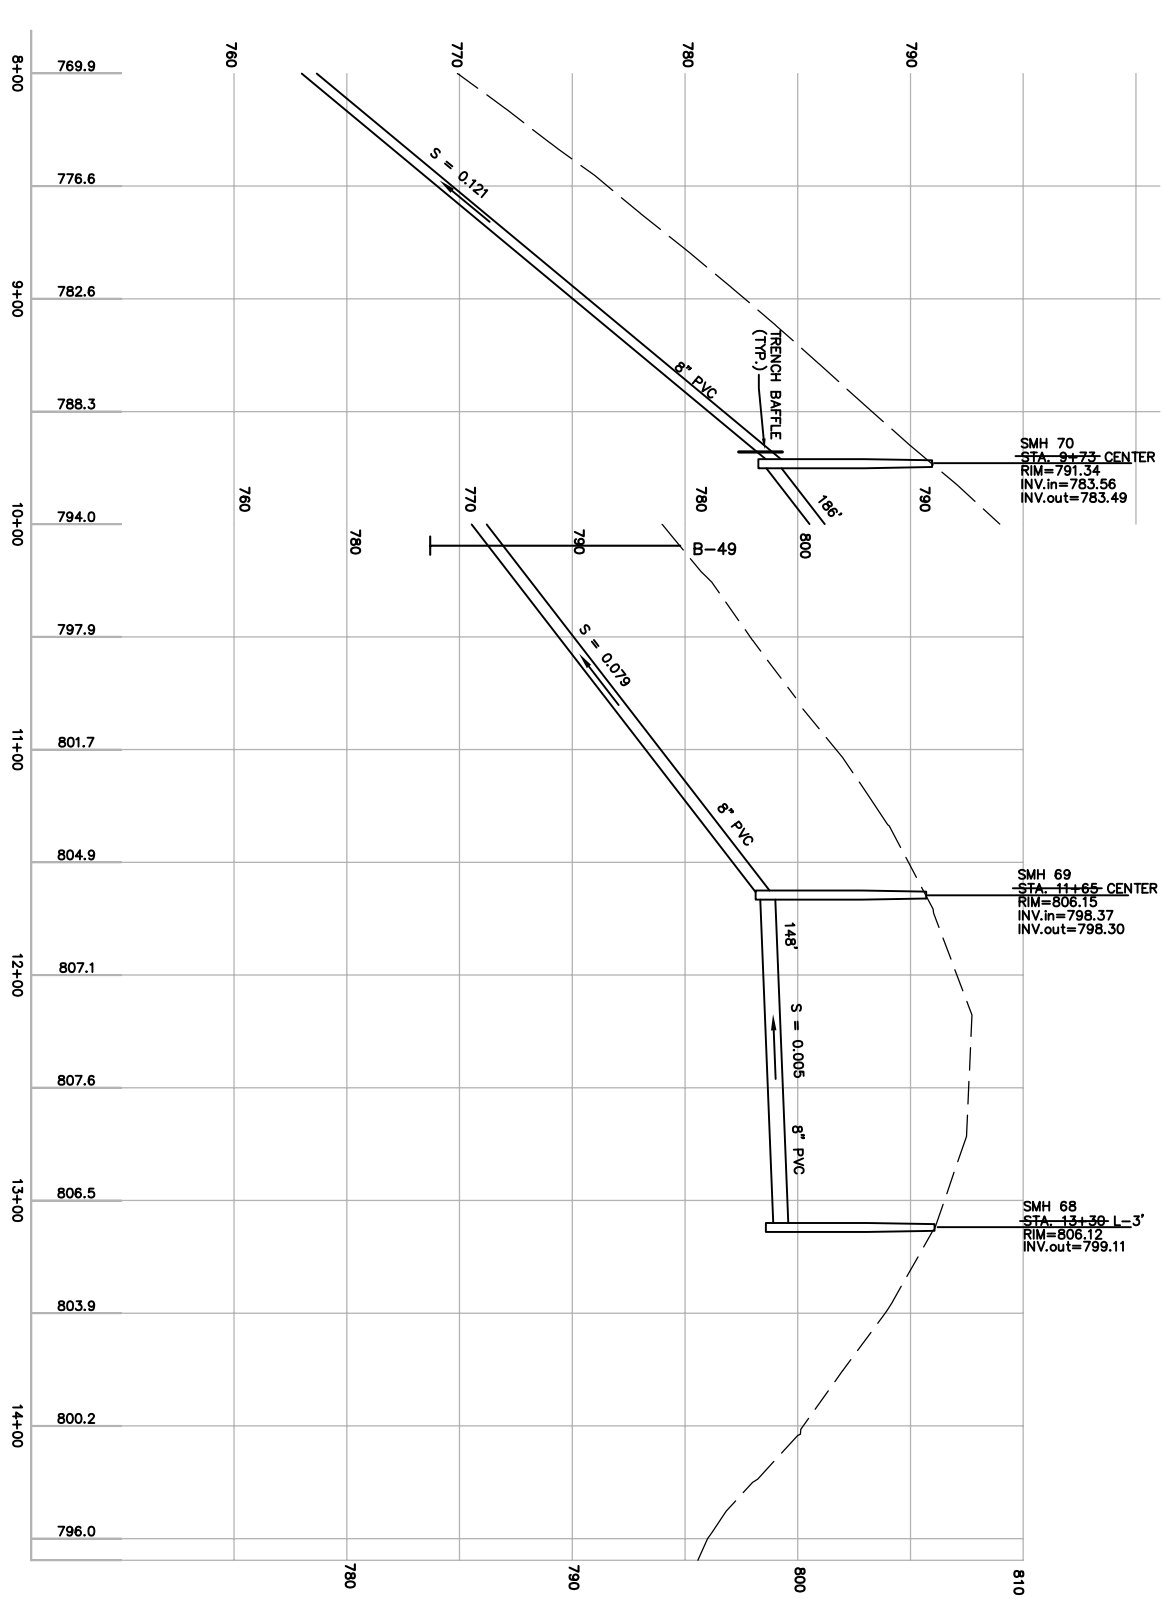

PROFILE
SCALE: 1"=40' HORZ.
1"=4' VERT.


RECORD DRAWING

I HEREBY CERTIFY THAT TO THE BEST OF MY KNOWLEDGE BASED UPON CONSTRUCTION RECORDS PROVIDED BY THE RESIDENT, ENGINEER AND THE CONTRACTOR, ALL WORK SHOWN ON THIS DRAWING HAS BEEN COMPLETED AS SHOWN.

HOYLE, TANNER & ASSOCIATES, INC.

NOTE:

ALL PROJECT REQUIREMENTS AS SET FORTH ON THIS SHEET HAVE BEEN REVIEWED FOR CONFORMANCE WITH THE MASSACHUSETTS DEPARTMENT OF CONSTRUCTION AND THE NOTE WORKING CONTAINED HEREON IS UNDERSTOOD TO BE PAST TENSE.

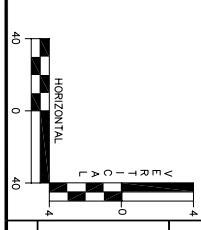

DRAWING NO. 19	CHERRY VALLEY SEWER DISTRICT LEICESTER, MASSACHUSETTS		HTA Hoyle, Tanner & Associates, Inc. 150 Dow Street • Manchester • New Hampshire 03101 Consulting Engineers		PROJECT NO. 105709	ENGINEER/ARCHITECT							
	PLAN AND PROFILE TOBIN ROAD STA. 8+00 TO 12+00		SCALE: AS SHOWN	DATE: APRIL 2001	DES. BY JAH	DR. BY CAB/RCP	CHKD. BY NLT	DO NOT SCALE DRAWING	1. RECORD DRAWING	C.B. W.C. W.C. 10/02			
SHEET 19 OF 38								REV.	DESCRIPTION	DR. BY	CHKD. BY	APPD. BY	DATE