




PLAN VIEW W/O ROOF

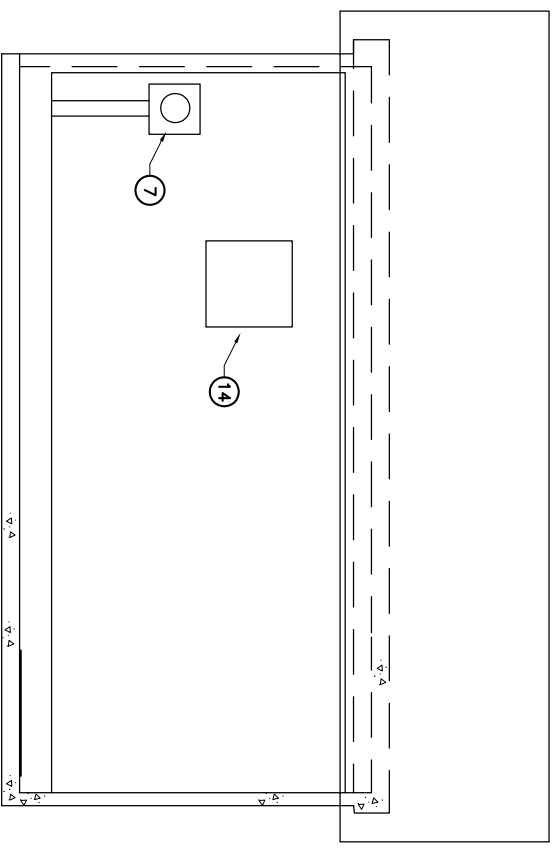

SECTION A-A
SOUTH VIEW (TOWTAID)

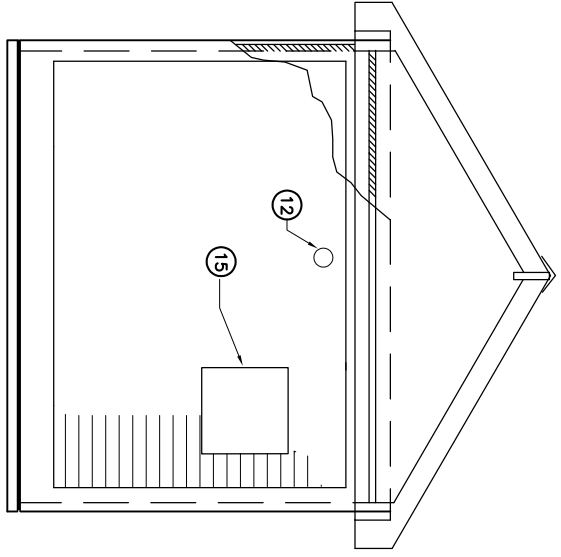

SIDE VIEW
WEST VIEW (TOWTAID)

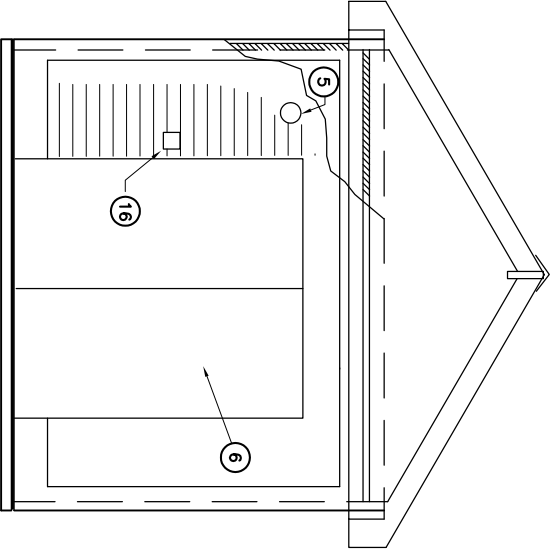

SIDE VIEW
EAST VIEW (TOWTAID)

- LEGEND**
- ① PRECAST CONCRETE PUMP BUILDING 10'-4"x16'-10"x8'-2" HIGH I.D.
 - ② 4' TWIN BULB FLUORESCENT LIGHT FIXTURES.
 - ③ 5KW ELECTRIC UNIT HEATER.
 - ④ GFCI RECEPTACLE.
 - ⑤ 75W EXTERIOR LIGHT.
 - ⑥ (2) 3'-0"x6'-8" STEEL DOOR FRAME (3 3/4") AND HARDWARE.
 - ⑦ ELECTRIC METER AND SOCKET.
 - ⑧ BUILDING MAIN DISCONNECT SWITCH.
 - ⑨ MAIN DISTRIBUTION PANEL.
 - ⑩ CONTROL PANEL.
 - ⑪ SINGLE POLE SWITCH.
 - ⑫ 4" DIA. WALL THIMBLE FOR GENERATOR EXHAUST.
 - ⑬ BATTERY CHARGER.
 - ⑭ ROOM INLET LOUVER
 - ⑮ ROOM OUTLET FAN & LOUVER
 - ⑯ KEY SWITCH - FAN/LOUVER MANUAL SWITCH
 - ⑰ TELEMETRY SYSTEM
 - ⑱ VARIABLE SPEED DRIVES

RECORD DRAWING

I HEREBY CERTIFY THAT TO THE BEST OF MY KNOWLEDGE, BASED UPON CONSTRUCTION RECORDS FROM THE FIELD, THIS DRAWING WAS PREPARED BY ME OR UNDER MY CLOSE PERSONAL SUPERVISION AND THE CONTRACTOR HAS BEEN ADVISED OF THE CONTENTS OF THIS DRAWING AND THE CONTRACTOR HAS BEEN ADVISED OF THE CONTRACTOR'S OBLIGATION TO VERIFY THE ACCURACY OF THE DRAWING AS SHOWN.

HOYLE, TANNER & ASSOCIATES, INC.

NOTE:

ALL PROJECT REQUIREMENTS AS SET FORTH ON THIS SHEET HAVE BEEN COMPLETED DURING THE COURSE OF CONSTRUCTION. ALL NOTE WORKING CONTAINED HEREON IS UNDERSTOOD TO BE FAST TENSE.

PROJECT NO.	105710	FILE NAME	BLDLAY-TOW
DO NOT SCALE DRAWING		DO NOT SCALE DRAWING	
REV.	DESCRIPTION	DR. BY	CHKD. BY
1.	RECORD DRAWING	S.R.	W.C.
		W.C.	3/03
		APPD. BY	DATE

HTA Hoyle, Tanner & Associates, Inc.
150 Dow Street • Manchester • New Hampshire 03101
Consulting Engineers

SCALE: AS SHOWN	DATE: FEB. 2002	DES. BY JAH	DR. BY CAB	CHKD. BY NLT
-----------------	-----------------	----------------	---------------	-----------------

CHERRY VALLEY SEWER DISTRICT
LEICESTER, MASSACHUSETTS
PLAN AND PROFILE
TOWTAID PARK PUMP STA.
PUMP BUILDING LAYOUT