




PLAN
SCALE: 1"=40'

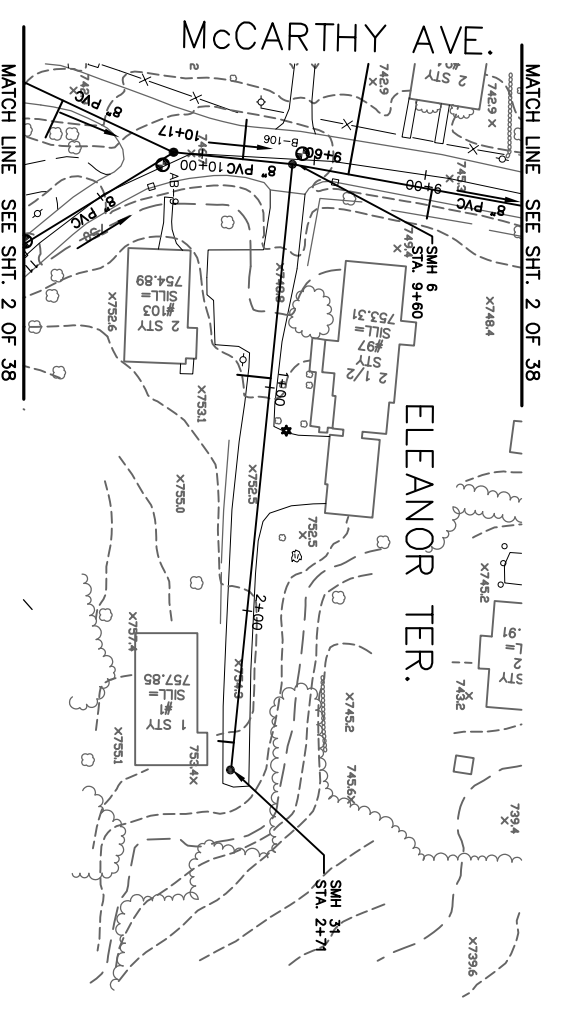

PLAN
SCALE: 1"=40'

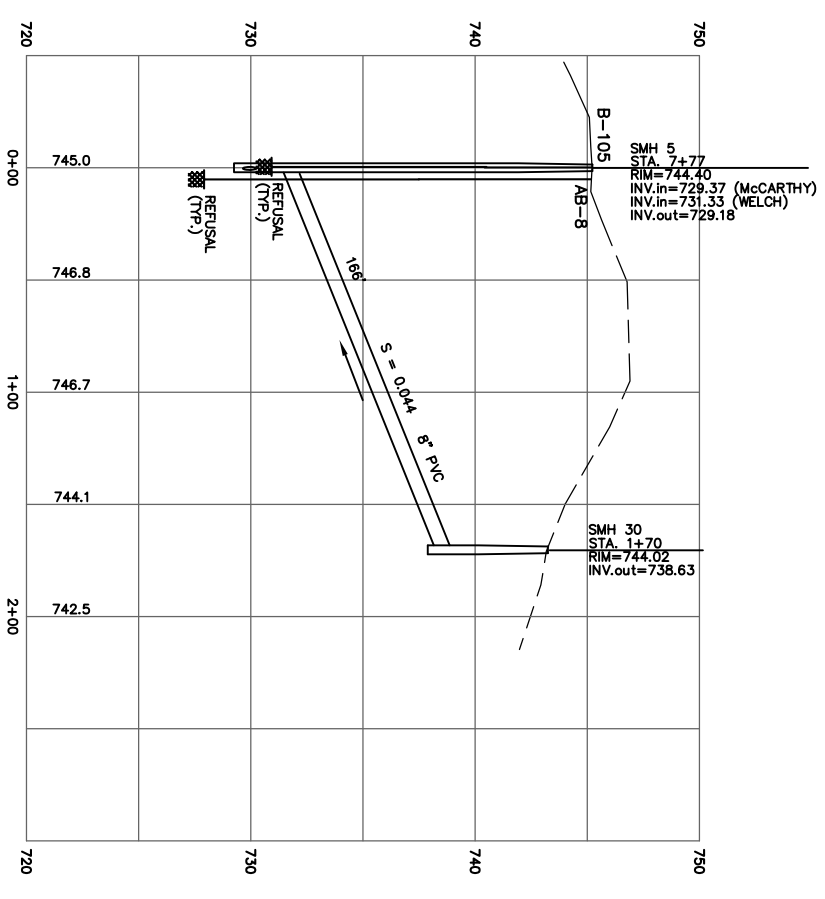

PROFILE
SCALE: 1"=40' HORIZ.
1"=4' VERT.

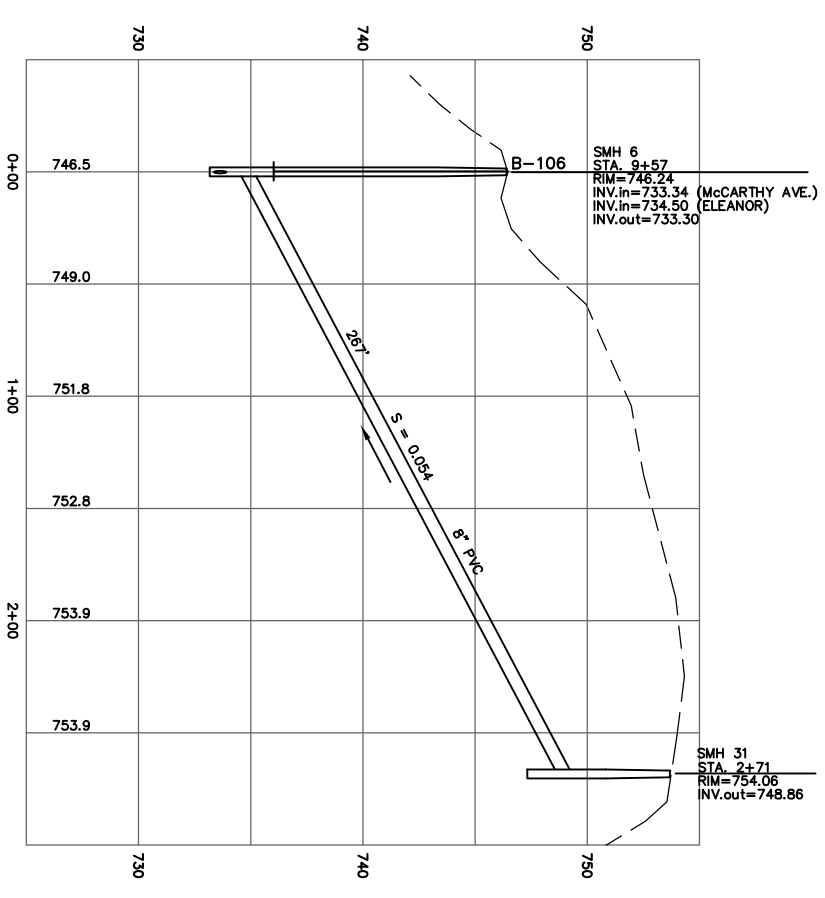


RECORD DRAWING

I HEREBY CERTIFY THAT TO THE BEST OF MY KNOWLEDGE BASED UPON CONSTRUCTION RECORDS PROVIDED BY THE RESIDENT ENGINEER AND THE CONTRACTOR, ALL WORK SHOWN ON THIS DRAWING HAS BEEN COMPLETED AS SHOWN.

HOYLE, TANNER & ASSOCIATES, INC.

NOTE:

ALL PROJECT REQUIREMENTS AS SHOWN ON THIS SHEET HAVE BEEN OBTAINED FROM THE COURSE OF CONSTRUCTION. ALL NOTE WORDING CONTAINED HEREON IS UNDERSTOOD TO BE PAST TENSE.

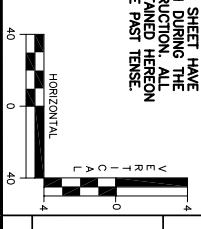

SHEET 10 OF 38	DRAWING NO. 10	CHERRY VALLEY SEWER DISTRICT LEICESTER, MASSACHUSETTS PLAN AND PROFILE		Hoyle, Tanner & Associates, Inc. 150 Dow Street • Manchester • New Hampshire 03101 Consulting Engineers			PROJECT NO. 105709				ENGINEER/ARCHITECT										
		WELCH CT. / ELEANOR TER.		SCALE: AS SHOWN	DATE: APRIL 2001	DES. BY JAH	DR. BY CAB/RCP	CHKD. BY NLT	FILE NAME ABPROF-09	DO NOT SCALE DRAWING		<table border="1"> <tr> <td>1.</td> <td>RECORD DRAWING</td> <td>C.B.</td> <td>W.C.</td> <td>W.C.</td> <td>10/02</td> </tr> <tr> <td>REV.</td> <td>DESCRIPTION</td> <td>DR. BY</td> <td>CHKD. BY</td> <td>APPR. BY</td> <td>DATE</td> </tr> </table>	1.	RECORD DRAWING	C.B.	W.C.	W.C.	10/02	REV.	DESCRIPTION	DR. BY
1.	RECORD DRAWING	C.B.	W.C.	W.C.	10/02																
REV.	DESCRIPTION	DR. BY	CHKD. BY	APPR. BY	DATE																