

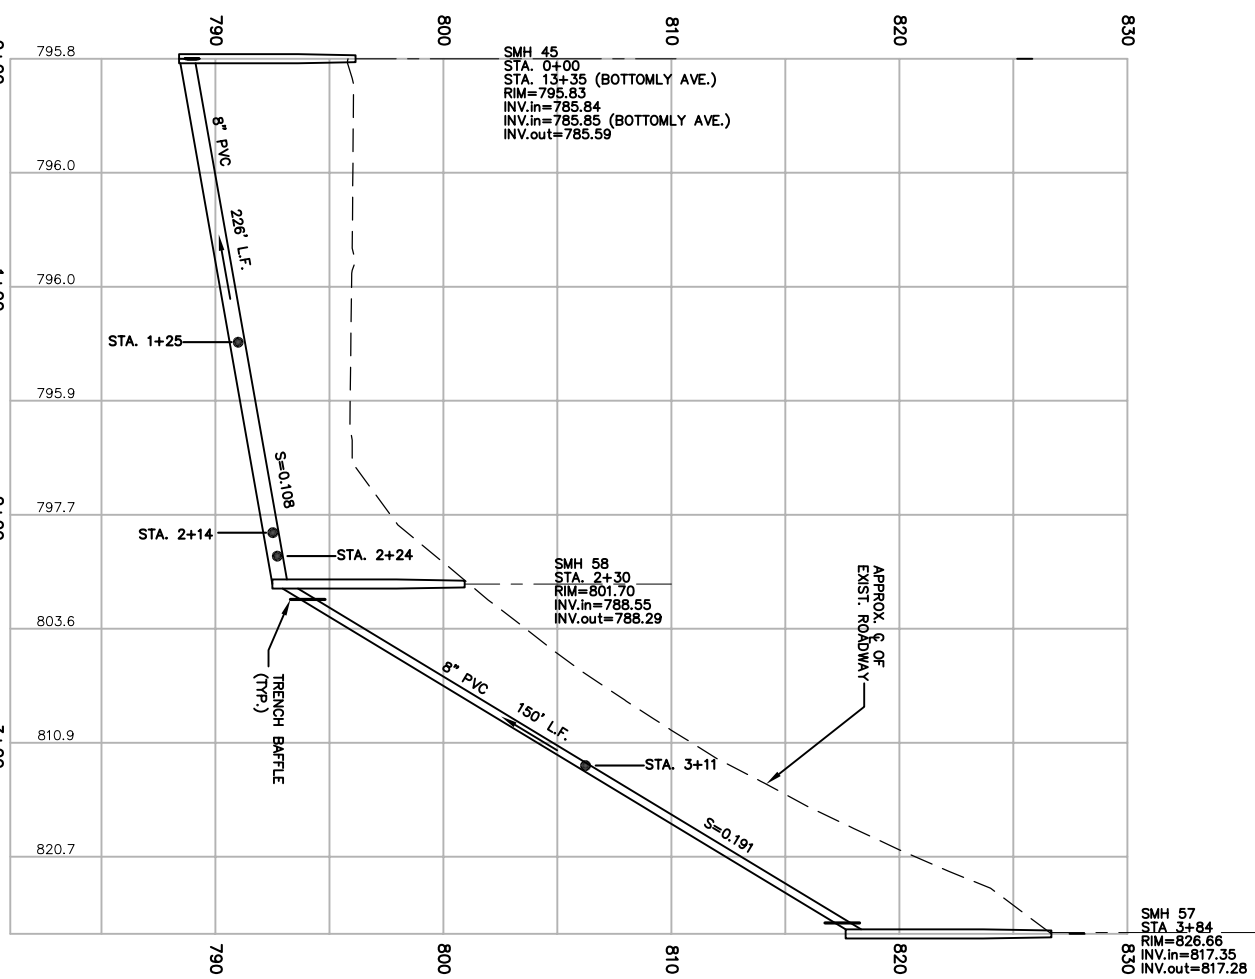


PLAN
SCALE: 1"=40'

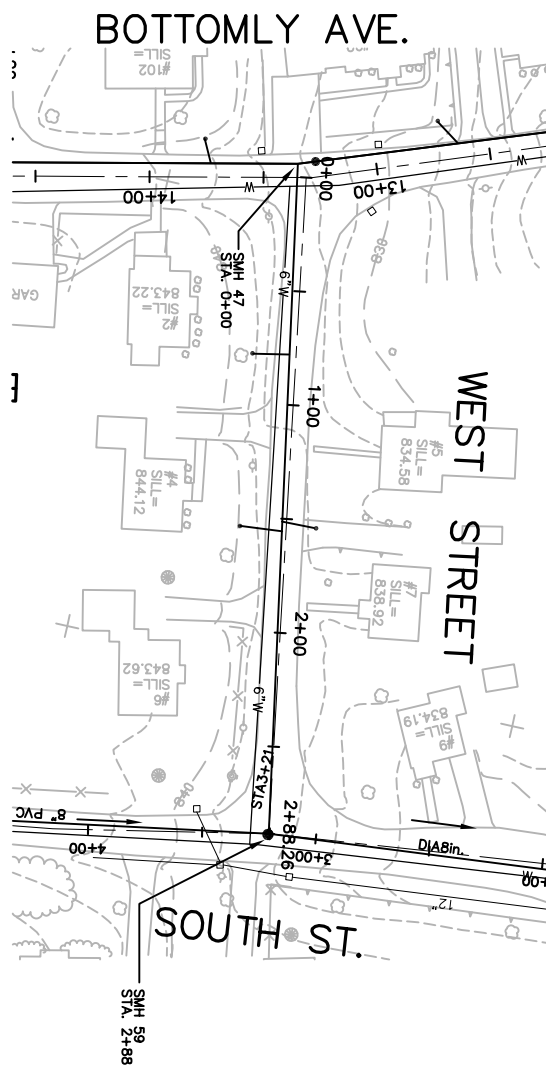

PROFILE
SCALE: 1"=40' HORIZ.
1"=4' VERT.

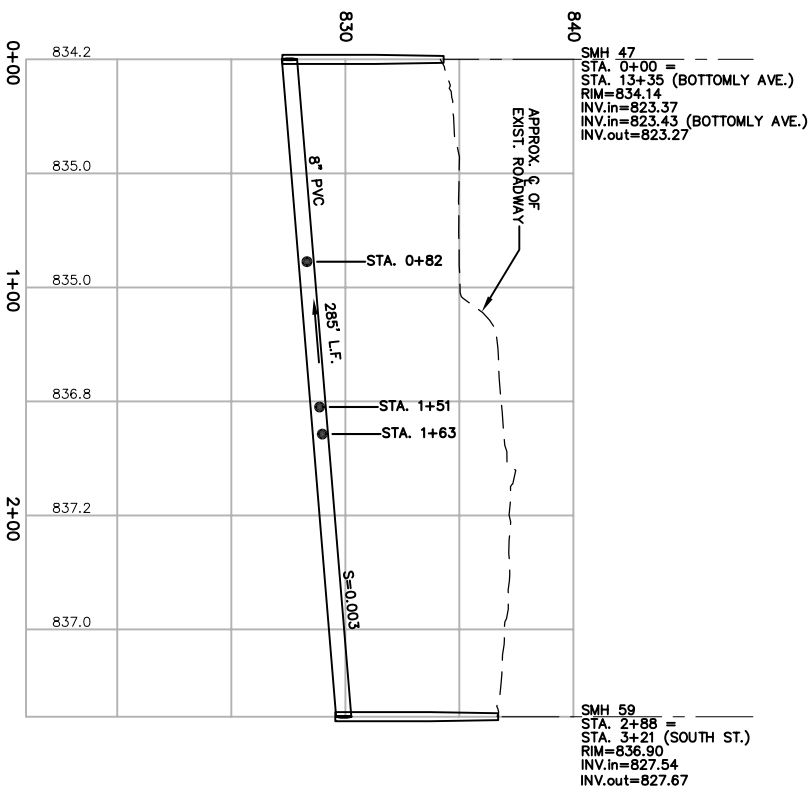


"AS-BUILT"

I HEREBY CERTIFY THAT TO THE BEST OF MY KNOWLEDGE, BASED UPON THE RECORD DRAWINGS PROVIDED BY THE RESIDENT ENGINEER AND THE CONTRACTOR, ALL WORK SHOWN ON THIS DRAWING HAS BEEN COMPLETED AS SHOWN.

HOYLE, TANNER & ASSOCIATES, INC.

SIGNED _____

DATE _____

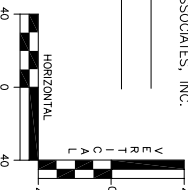

CHERRY VALLEY SEWER DISTRICT
LEICESTER, MASSACHUSETTS

PLAN AND PROFILE

WEST ST./NORTH CT.



Hoyle, Tanner & Associates, Inc.
150 Dow Street • Manchester • New Hampshire 03101
Consulting Engineers

SCALE: AS SHOWN

DATE: APRIL 2000

DES. BY
JAH

DR. BY
RCP

CHKD. BY
NLT

PROJECT NO.

105707

FILE NAME

AB105P17

DO NOT SCALE DRAWING

REV.	DESCRIPTION	DR. BY	CHKD. BY	APPD. BY	DATE
1.	AS-BUILTS	C.B.	J.H.	J.H.	10/00

ENGINEER/ARCHITECT