



ACCESS OPENING SHALL BE FITTED WITH A PERMANENTLY INSTALLED, RAIL MOUNTED, RETRACTABLE FALL PREVENTION SYSTEM THAT FACILITATES ACCESS TO THE CONFINED SPACE. THIS SYSTEM SHALL BE A HATCH NET 121 AS MANUFACTURED BY SAFE APPROACH INC., AUBURN, ME (800)471-1157.

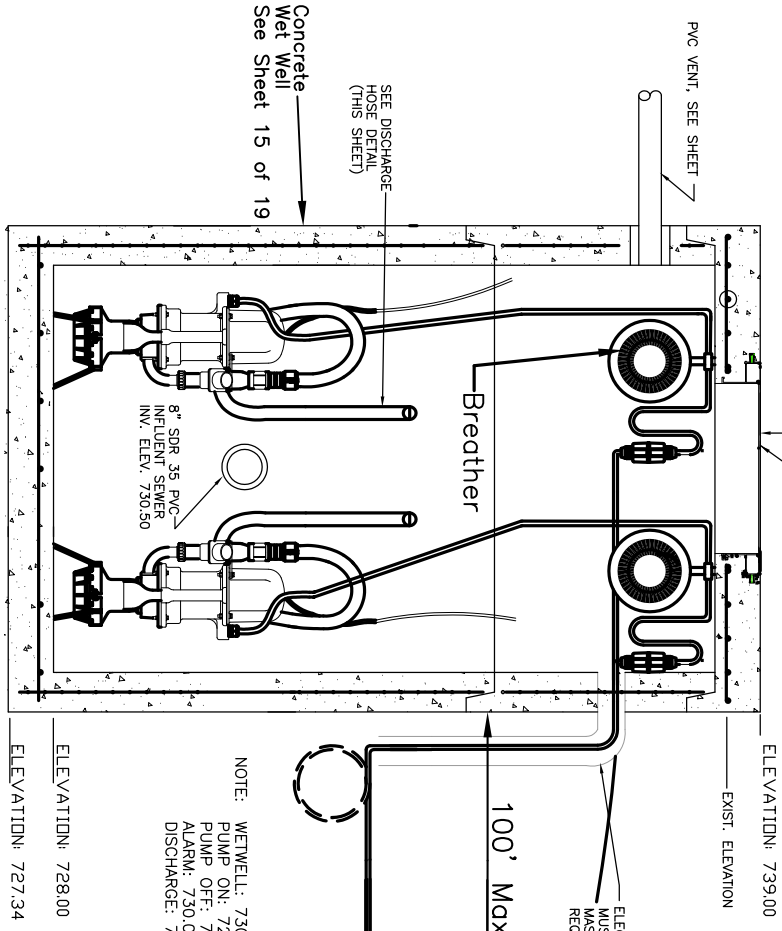

NOTE: WETWELL: 730.50
PUMP ON: 729.42
PUMP OFF: 729.08
ALARM: 730.08
DISCHARGE: 732.50

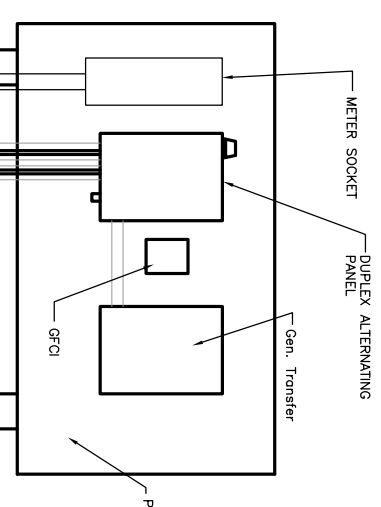

ELECTRICAL CONDUIT SHALL BE INSTALLED IN ACCORDANCE WITH MASSACHUSETTS' ELECTRIC REQUIREMENTS

100' Max. Cable
24" Min.

SERIES B1A - Special
(PATENTED TRASH BASKET SYSTEM)

STANDARD FEATURES:
• ALL ALUMINUM CONSTRUCTION
• PERFORATED SCREENING STRIPS
• REMOVABLE ALUMINUM CRIBBLES SYSTEM

REQUIREMENTS:
THE BIA SERIES TRASH BASKET SYSTEM IS MANUFACTURED BY RAINBOW SYSTEMS, INC. ALL ALUMINUM CONSTRUCTION SHALL BE OF 6061 ALUMINUM WITH ANODIZED FINISH. THE BASKET SCREEN SHALL BE OF 20 GA. ALUMINUM WITH ANODIZED FINISH. ALL PARTS SHALL BE OF 6061 ALUMINUM WITH ANODIZED FINISH. THE BASKET SHALL BE CAPABLE OF WITHSTANDING A LOAD OF 500 LBS. THE BASKET SHALL BE CAPABLE OF WITHSTANDING A LOAD OF 500 LBS. THE BASKET SHALL BE CAPABLE OF WITHSTANDING A LOAD OF 500 LBS. THE BASKET SHALL BE CAPABLE OF WITHSTANDING A LOAD OF 500 LBS.

TRASH BASKET
NOT TO SCALE

STANDARD LATERAL KIT
NOT TO SCALE

(F.R. MAHONY & ASSOCIATES, INC.)
(978-597-0703)

USE BRASS OR SCHEDULE 80 PVC FITTINGS

'RECORD DRAWING'

I HEREBY CERTIFY THAT TO THE BEST OF MY KNOWLEDGE, BASED UPON CONSTRUCTION RECORDS PROVIDED BY THE RESIDENT ENGINEER AND THE CONTRACTOR, ALL WORK SHOWN ON THIS DRAWING HAS BEEN COMPLETED AS SHOWN.

HOYLE, TANNER & ASSOCIATES, INC.

NOTE:
ALL PROJECT REQUIREMENTS AS SET FORTH ON THIS SHEET HAVE BEEN COMPLIED WITH DURING THE COURSE OF CONSTRUCTION. ALL NOTE WORDING CONTAINED HEREON IS UNDERSTOOD TO BE PAST TENSE.

CHERRY VALLEY SEWER DISTRICT
LEICESTER, MASSACHUSETTS

WILLOW HILL
PUMP STATION DETAILS

HTA Hoyle, Tanner & Associates, Inc.
150 Dow Street • Manchester • New Hampshire 03101
Consulting Engineers

PROJECT NO.
105710

FILE NAME
WILLPSTA-DET

DO NOT SCALE DRAWING

REV.	DESCRIPTION	DR. BY	CHKD. BY	APPD. BY	DATE
1.	RECORD DRAWING	S.R.	W.C.	W.C.	3/03

DRAWING NO.
15