


RESERVOIR STREET

PLAN
SCALE: 1"=40'

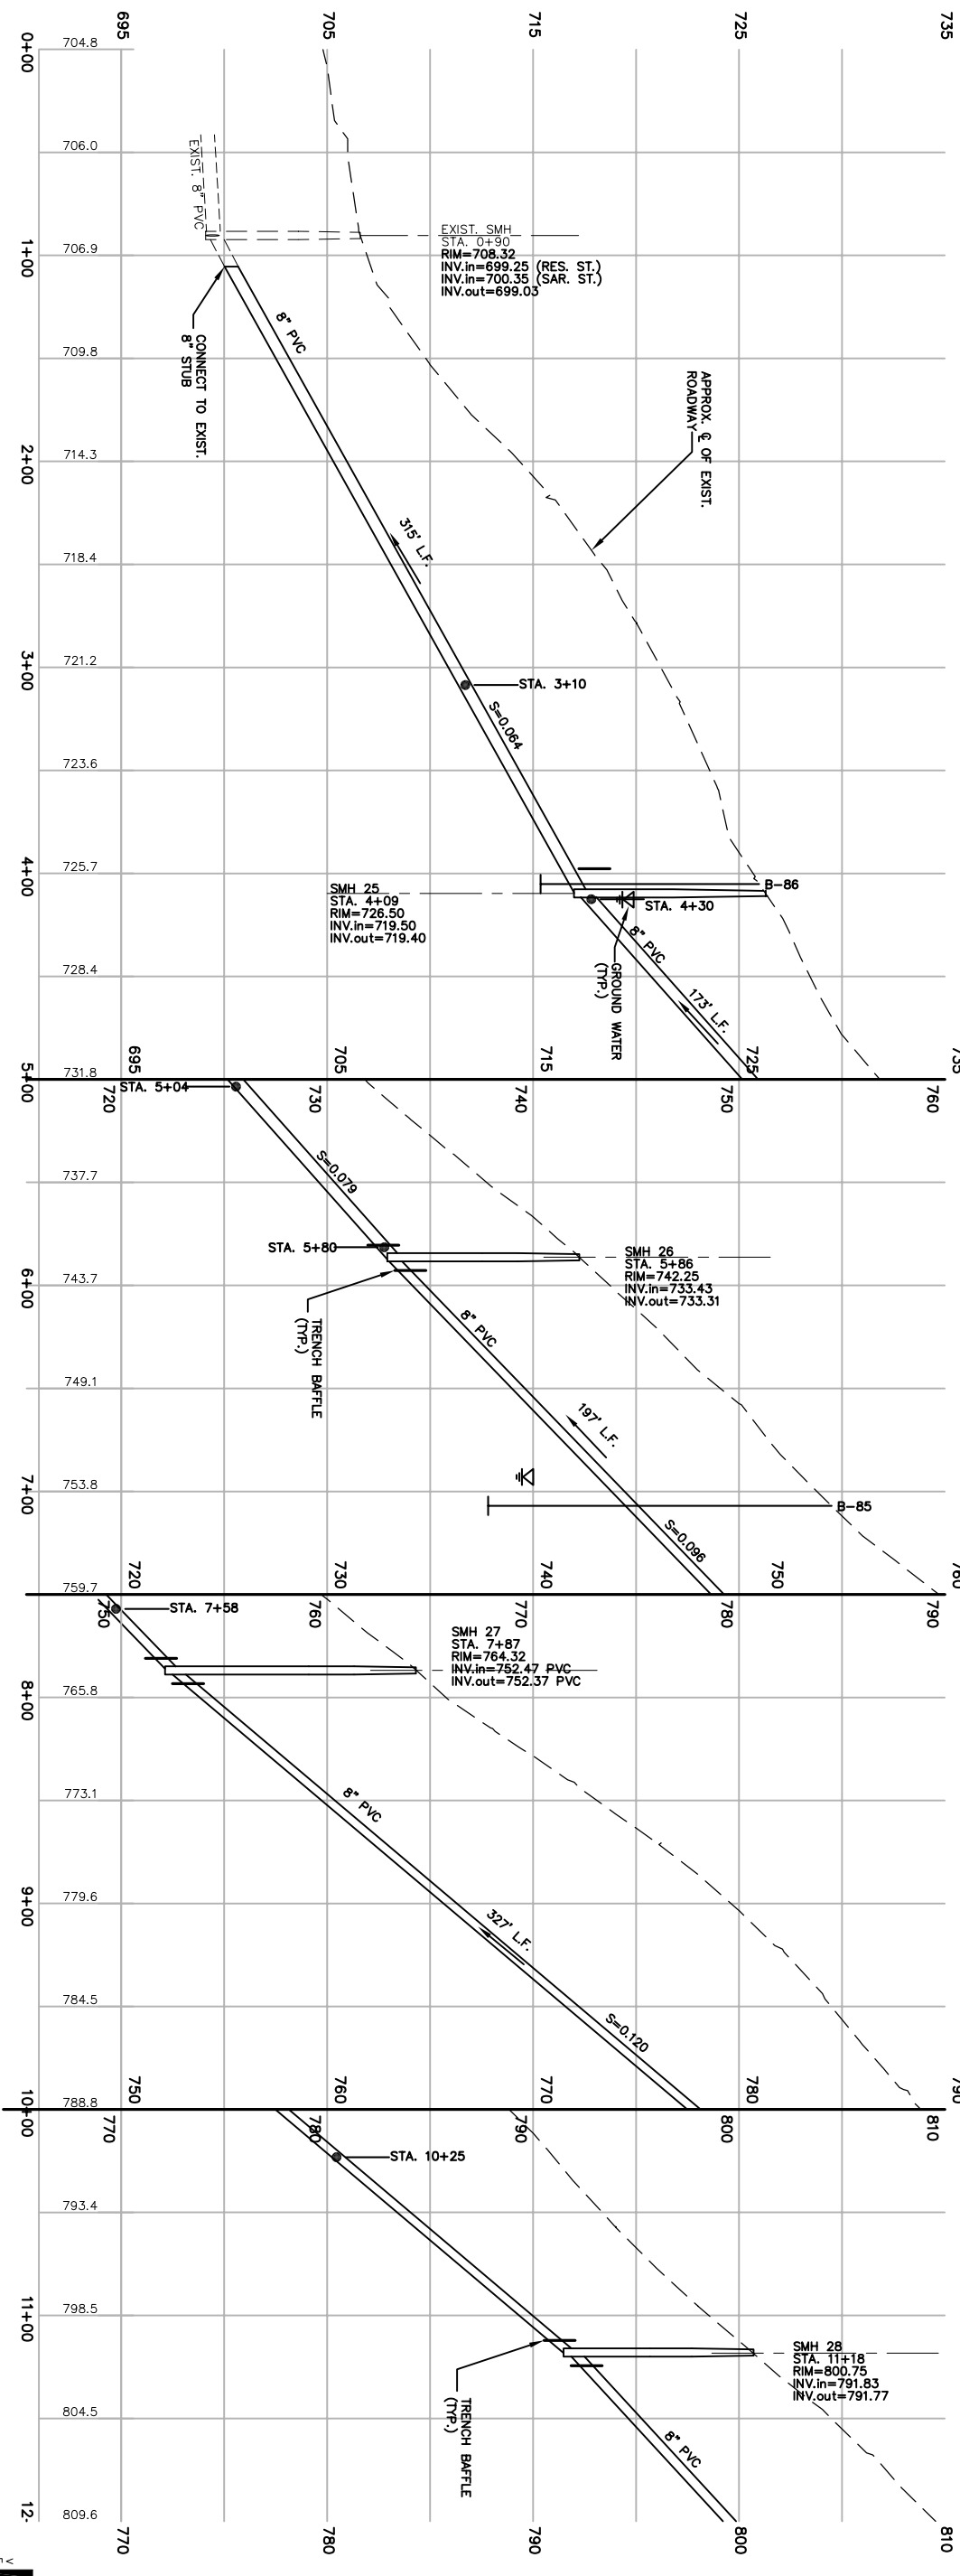


PROFILE
SCALE: 1"=40' HORIZ.
1"=4' VERT.

AS-BUILT

I HEREBY CERTIFY THAT TO THE BEST OF MY KNOWLEDGE BASED UPON CONSTRUCTION RECORDS PROVIDED BY THE RESIDENT ENGINEER AND THE CONTRACTOR, ALL WORK SHOWN ON THIS DRAWING HAS BEEN COMPLETED AS SHOWN.

HOYLE, TANNER & ASSOCIATES, INC.
SIGNED: _____
DATE: _____

MATCH LINE SEE SHEET 7 OF 18

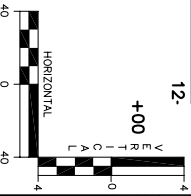

CHERRY VALLEY SEWER DISTRICT
LEICESTER, MASSACHUSETTS
PLAN AND PROFILE

RESERVOIR STREET
0+00 TO 12+00

DRAWING NO. **7**

SHEET 7 OF 18

HTA Hoyle, Tanner & Associates, Inc.
150 Dow Street • Manchester • New Hampshire 03101
Consulting Engineers

SCALE: AS SHOWN DATE: APRIL 2000 DES. BY JAH DR. BY RCP CHKD. BY NLT

PROJECT NO.	105707	FILE NAME	AB105P05
DO NOT SCALE DRAWING			
REV.	DESCRIPTION	DR. BY	CHKD. BY
1.	AS-BUILTS	C.B.	J.H.
		J.H.	10/00
			DATE

ENGINEER/ARCHITECT