

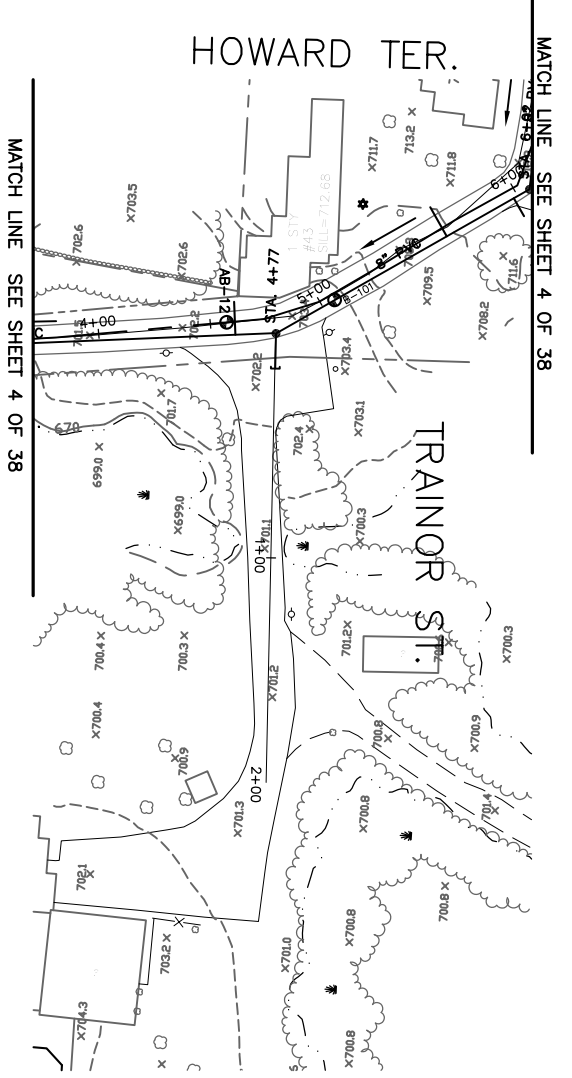


PLAN
SCALE: 1"=40'

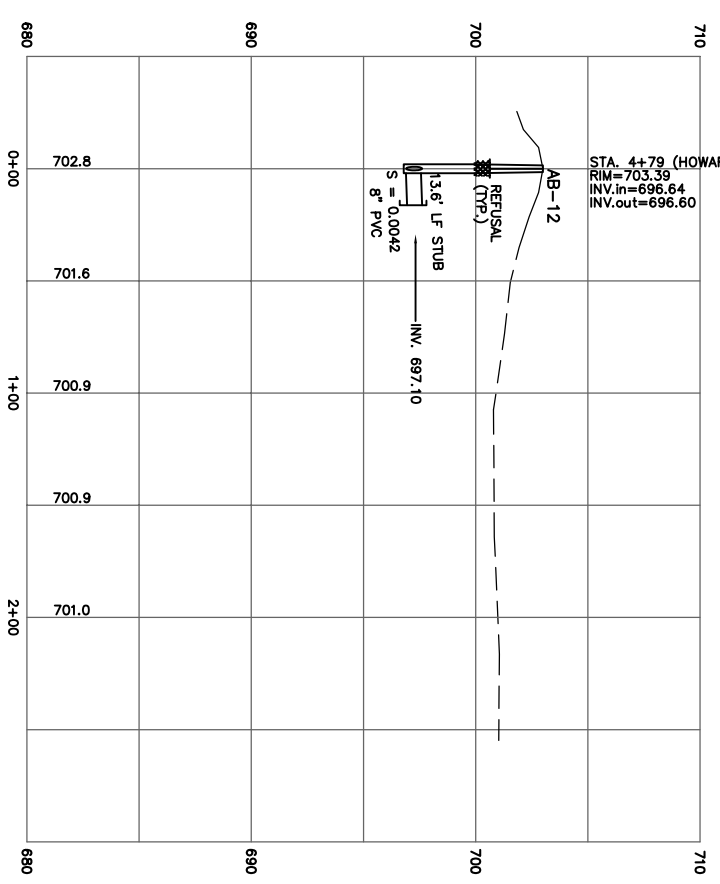

PLAN
SCALE: 1"=40'

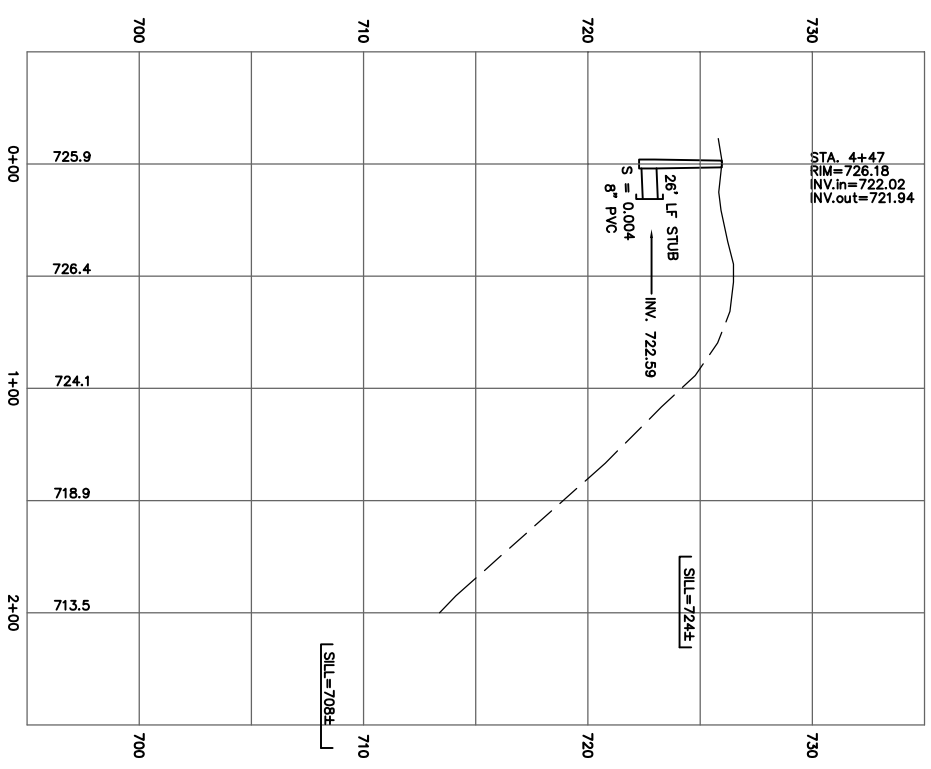

RECORD DRAWING


I HEREBY CERTIFY THAT TO THE BEST OF MY KNOWLEDGE, BASED UPON CONSTRUCTION RECORDS PROVIDED BY THE RESIDENT ENGINEER AND THE CONTRACTOR, THIS DRAWING HAS BEEN COMPLETED AS SHOWN.

HOYLE, TANNER & ASSOCIATES, INC.

NOTE:

ALL PROJECT REQUIREMENTS AS SET FORTH ON THIS SHEET HAVE BEEN COMPLIED WITH DURING THE COURSE OF CONSTRUCTION. ALL NOTE WORKING CONTAINED HEREON IS UNDERSTOOD TO BE PAST TENSE.

PROFILE
SCALE: 1"=40' HORIZ.
1"=4' VERT.

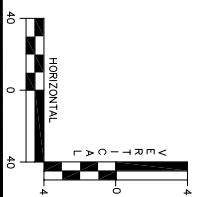

DRAWING NO. 5	CHERRY VALLEY SEWER DISTRICT LEICESTER, MASSACHUSETTS PLAN AND PROFILE PRIVATE DR. / TRAINOR ST.	Hoyle, Tanner & Associates, Inc. 150 Dow Street • Manchester • New Hampshire 03101 Consulting Engineers	PROJECT NO. 105709	1. RECORD DRAWING C.B. W.C. W.C. 10/02	DR. BY: _____ CHKD. BY: _____ APPD. BY: _____ DATE: _____	
			FILE NAME ABPROF-10			DO NOT SCALE DRAWING
SHEET 5 OF 38		SCALE: AS SHOWN	DATE: APRIL 2001	DES. BY: JAH	DR. BY: CAB/RCP	CHKD. BY: NLT

ENGINEER/ARCHITECT