


PLAN
SCALE: 1"=40'

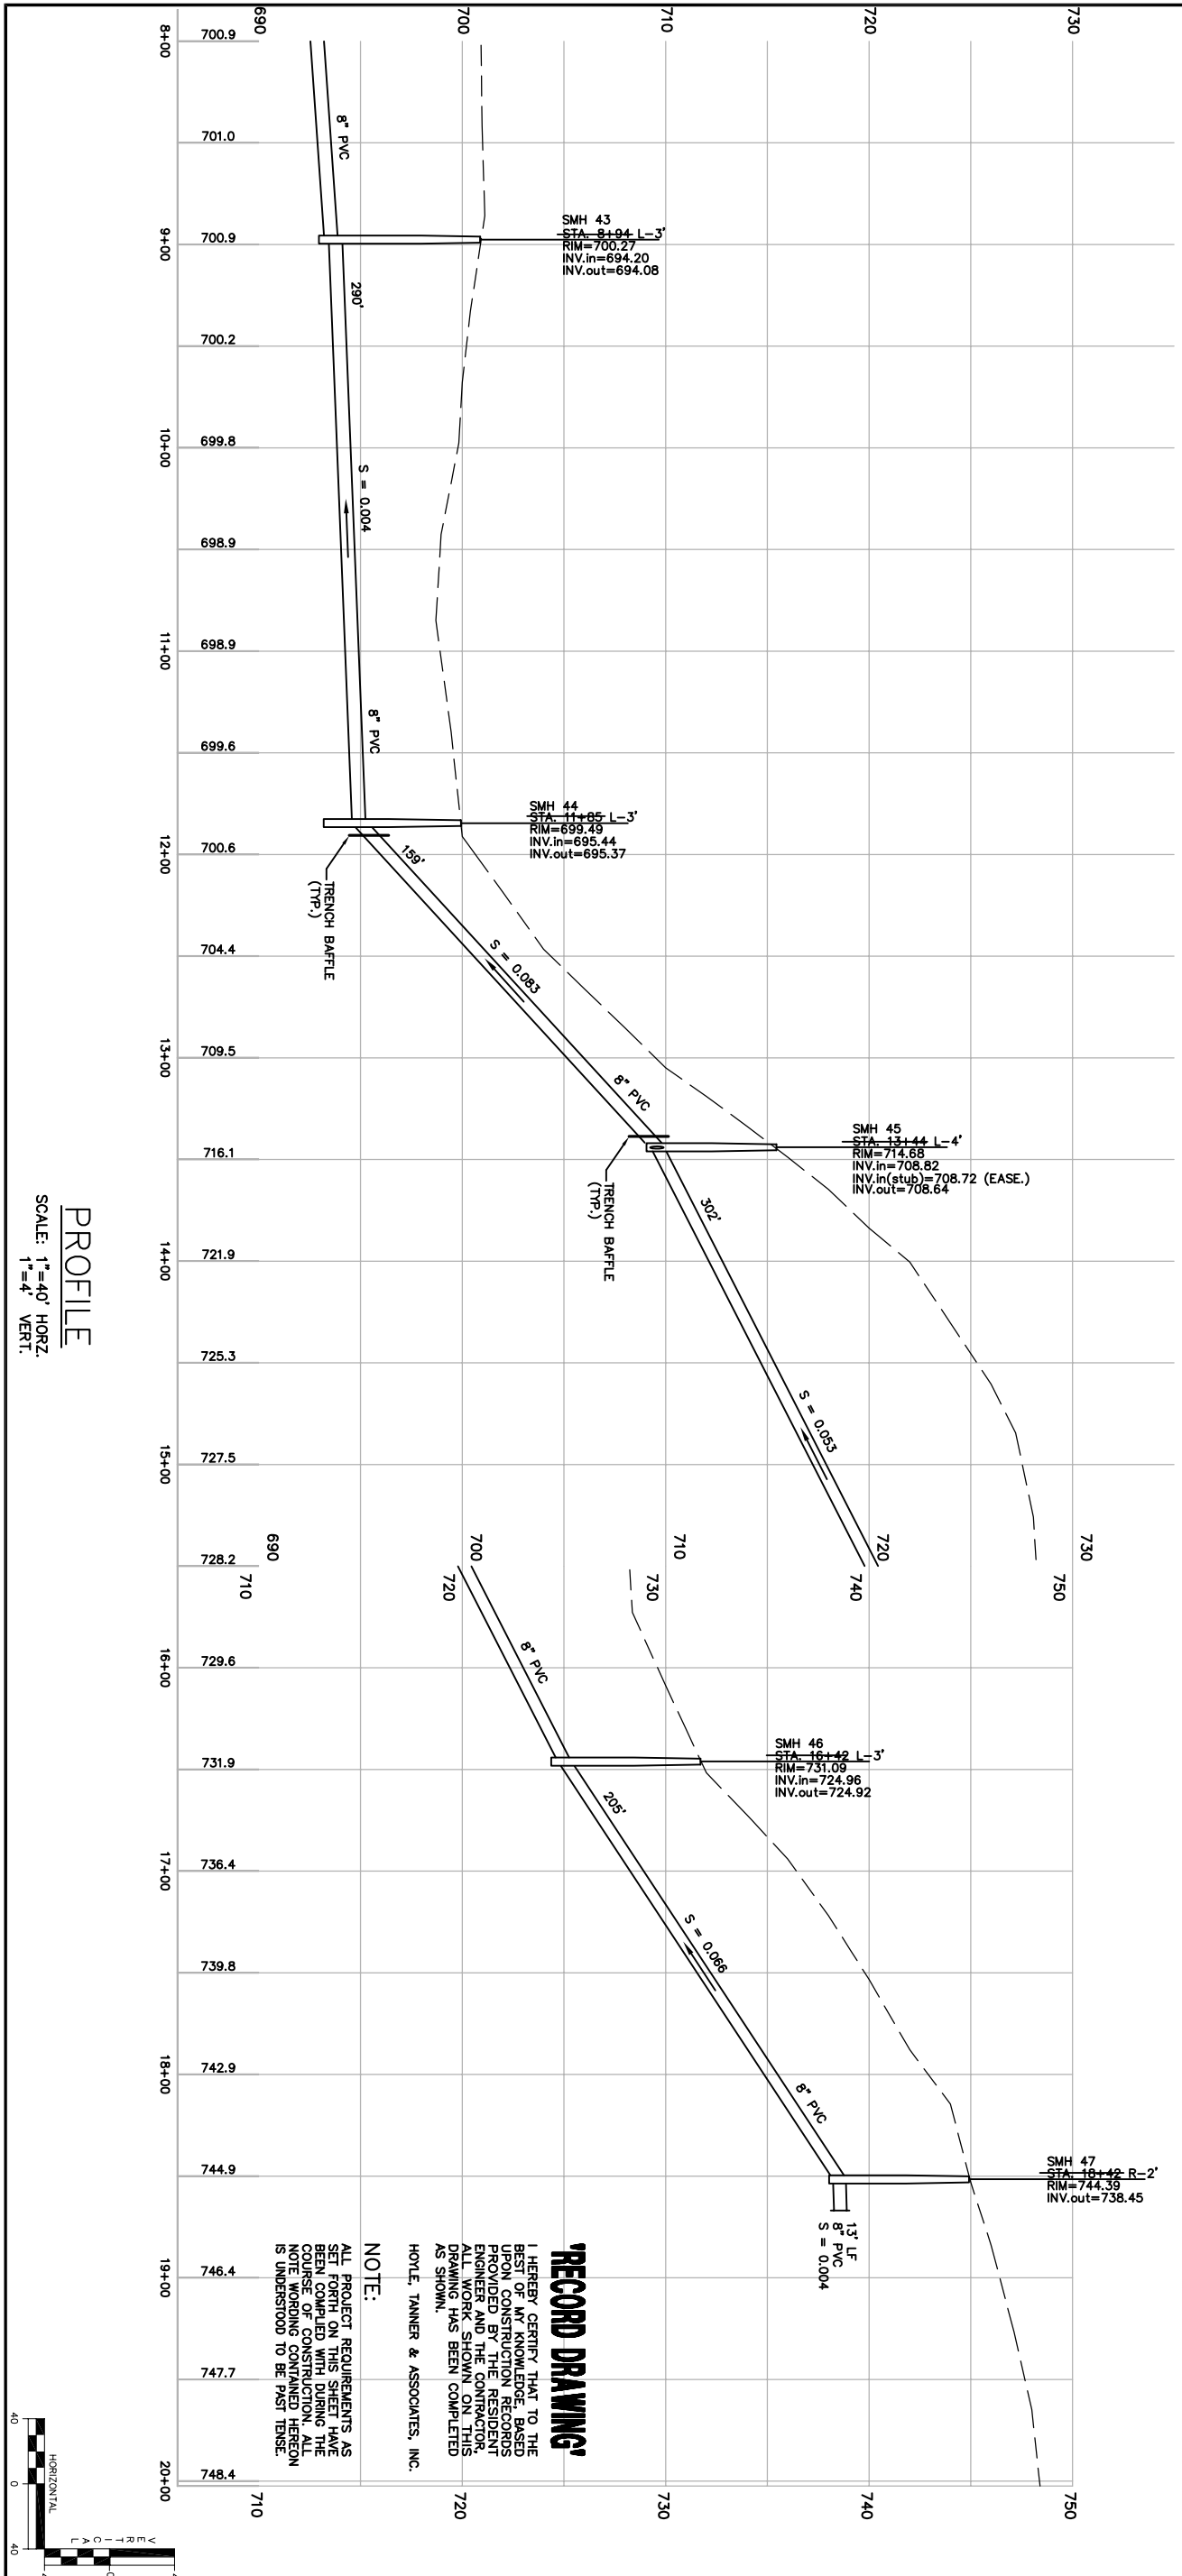


PROFILE
SCALE: 1"=40' HORIZ.
1"=4' VERT.

NOTE:
ALL PROJECT REQUIREMENTS AS SET FORTH ON THIS SHEET HAVE BEEN REVIEWED AND FOUND TO BE IN ACCORDANCE WITH THE COURSE OF CONSTRUCTION. ALL NOTE WORKING CONTAINED HEREON IS UNDERSTOOD TO BE PAST TENSE.

NOTE:
I HEREBY CERTIFY THAT TO THE BEST OF MY KNOWLEDGE, BASED UPON CONSTRUCTION RECORDS PROVIDED BY THE RESIDENT ENGINEER AND THE CONTRACTOR, ALL WORK SHOWN ON THIS DRAWING HAS BEEN COMPLETED AS SHOWN.

HOYLE, TANNER & ASSOCIATES, INC.

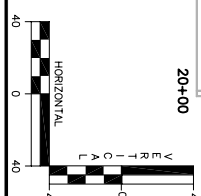

CHERRY VALLEY SEWER DISTRICT LEICESTER, MASSACHUSETTS		HTA Hoyle, Tanner & Associates, Inc. 150 Dow Street • Manchester • New Hampshire 03101 Consulting Engineers		PROJECT NO. 105709	ENGINEER/ARCHITECT	
PLAN AND PROFILE		SCALE: AS SHOWN		FILE NAME ABPROF-13	DATE	
BOYD STREET STA. 8+00 TO 18+45		DATE: APRIL 2001	DES. BY JAH	DR. BY CAB/RCP	CHKD. BY NLT	1. RECORD DRAWING
DRAWING NO. 13		DO NOT SCALE DRAWING		REV.		C.B. W.C. W.C. 10/02
SHEET 13 OF 38						DR. BY CHKD. BY APPD. BY