


PLAN  
SCALE: 1"=20'

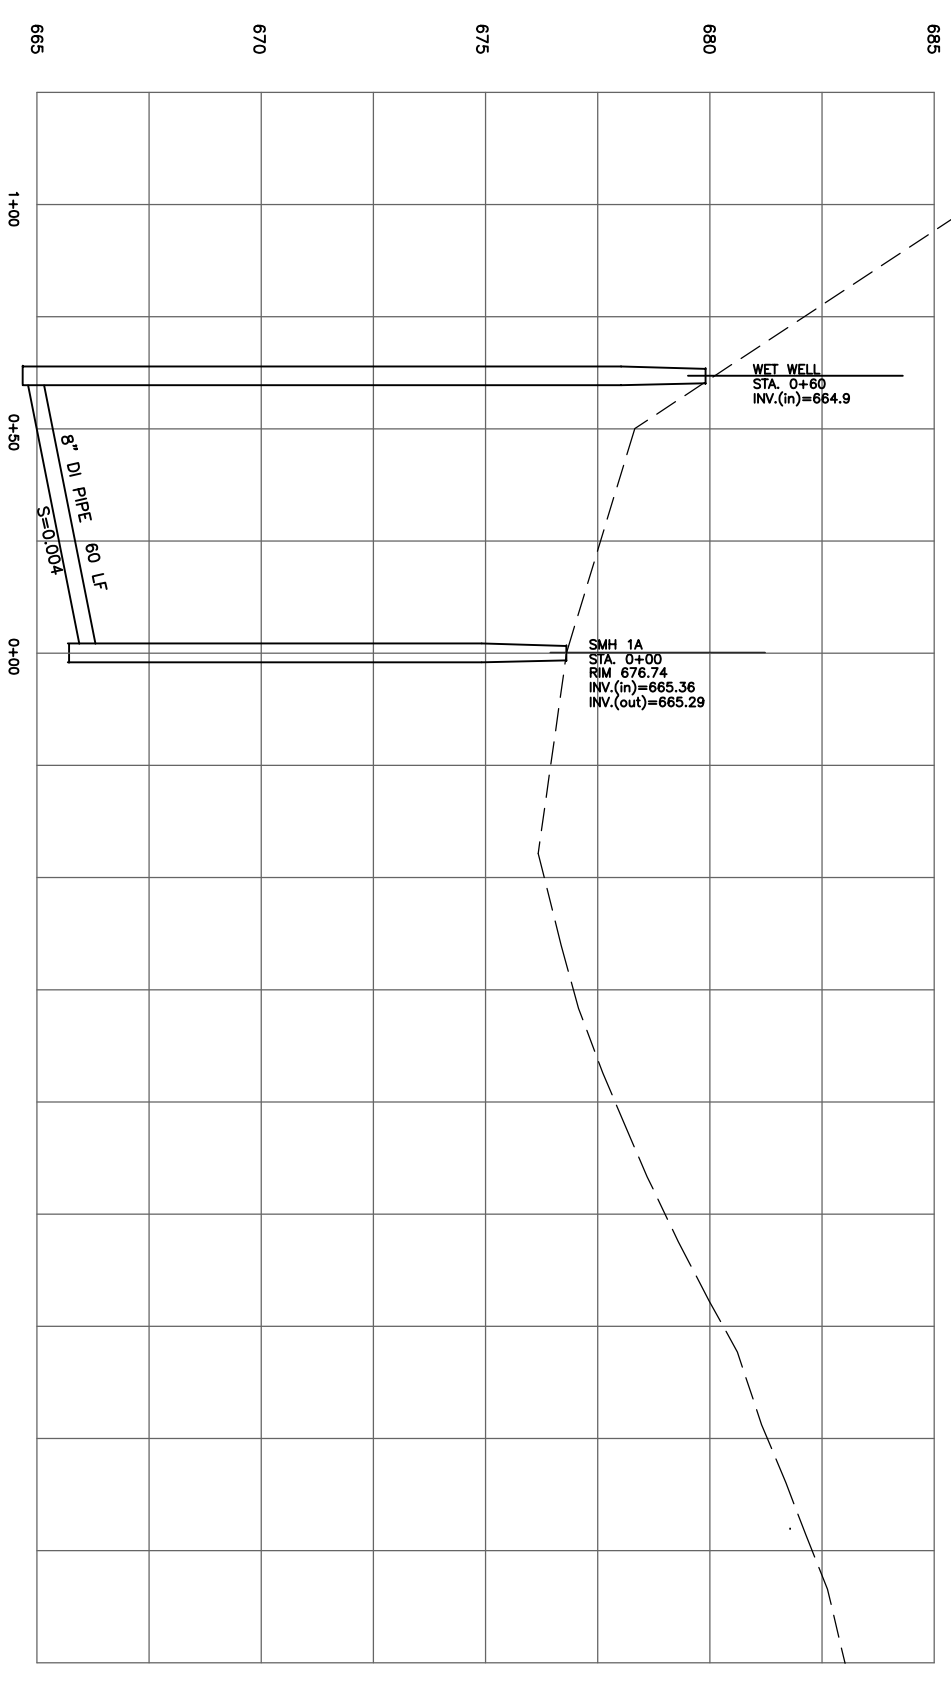

PROFILE  
SCALE: 1"=20' HOR.  
1"=2' VER.

- NOTES:
- ONCE WETWELL IS SET IN PLACE AND PRIOR TO INSTALLATION OF FUMES AND CONTROL THE WETWELL SHALL BE COATED WITH A TWO PART EPOXY SYSTEM. CONTACT: DAN WARREN OF WARREN ENVIRONMENTAL AT 508-866-5277. COST IS INCIDENTAL AND SHALL BE INCLUDED IN UNIT COST.
  - SMH-1A WILL REQUIRE CORE AND BOOT INSTALLED.

**'RECORD DRAWING'**

I HEREBY CERTIFY THAT TO THE BEST OF MY KNOWLEDGE, BASED UPON CONSTRUCTION RECORDS PROVIDED BY THE RESIDENT ENGINEER AND THE RECORD DRAWING, ALL WORK SHOWN ON THIS DRAWING HAS BEEN COMPLETED AS SHOWN.

HOYLE, TANNER & ASSOCIATES, INC.

NOTE:  
ALL PROJECT REQUIREMENTS AS SET FORTH ON THIS SHEET HAVE BEEN COMPLETED DURING THE COURSE OF CONSTRUCTION. ALL NOTE WORKING CONTAINED HEREON IS UNDERSTOOD TO BE PAST TENSE.

CHERRY VALLEY SEWER DISTRICT  
LEICESTER, MASSACHUSETTS

McCARTHY AVE. PUMP STATION  
GRAVITY SEWER LINE TO PUMP STA.

**HTA** Hoyle, Tanner & Associates, Inc.  
150 Dow Street • Manchester • New Hampshire 03101  
Consulting Engineers

PROJECT NO.  
105710

FILE NAME  
McCARTH-PSTA

SCALE: AS SHOWN    DATE: FEB. 2002    DES. BY JAH    DR. BY CAB    CHKD. BY NLT

REV.	DESCRIPTION	S.R.	W.C.	W.C.	3/03
1.	RECORD DRAWING	DR. BY	CHKD. BY	APPR. BY	DATE

