


PLAN
SCALE: 1"=40'

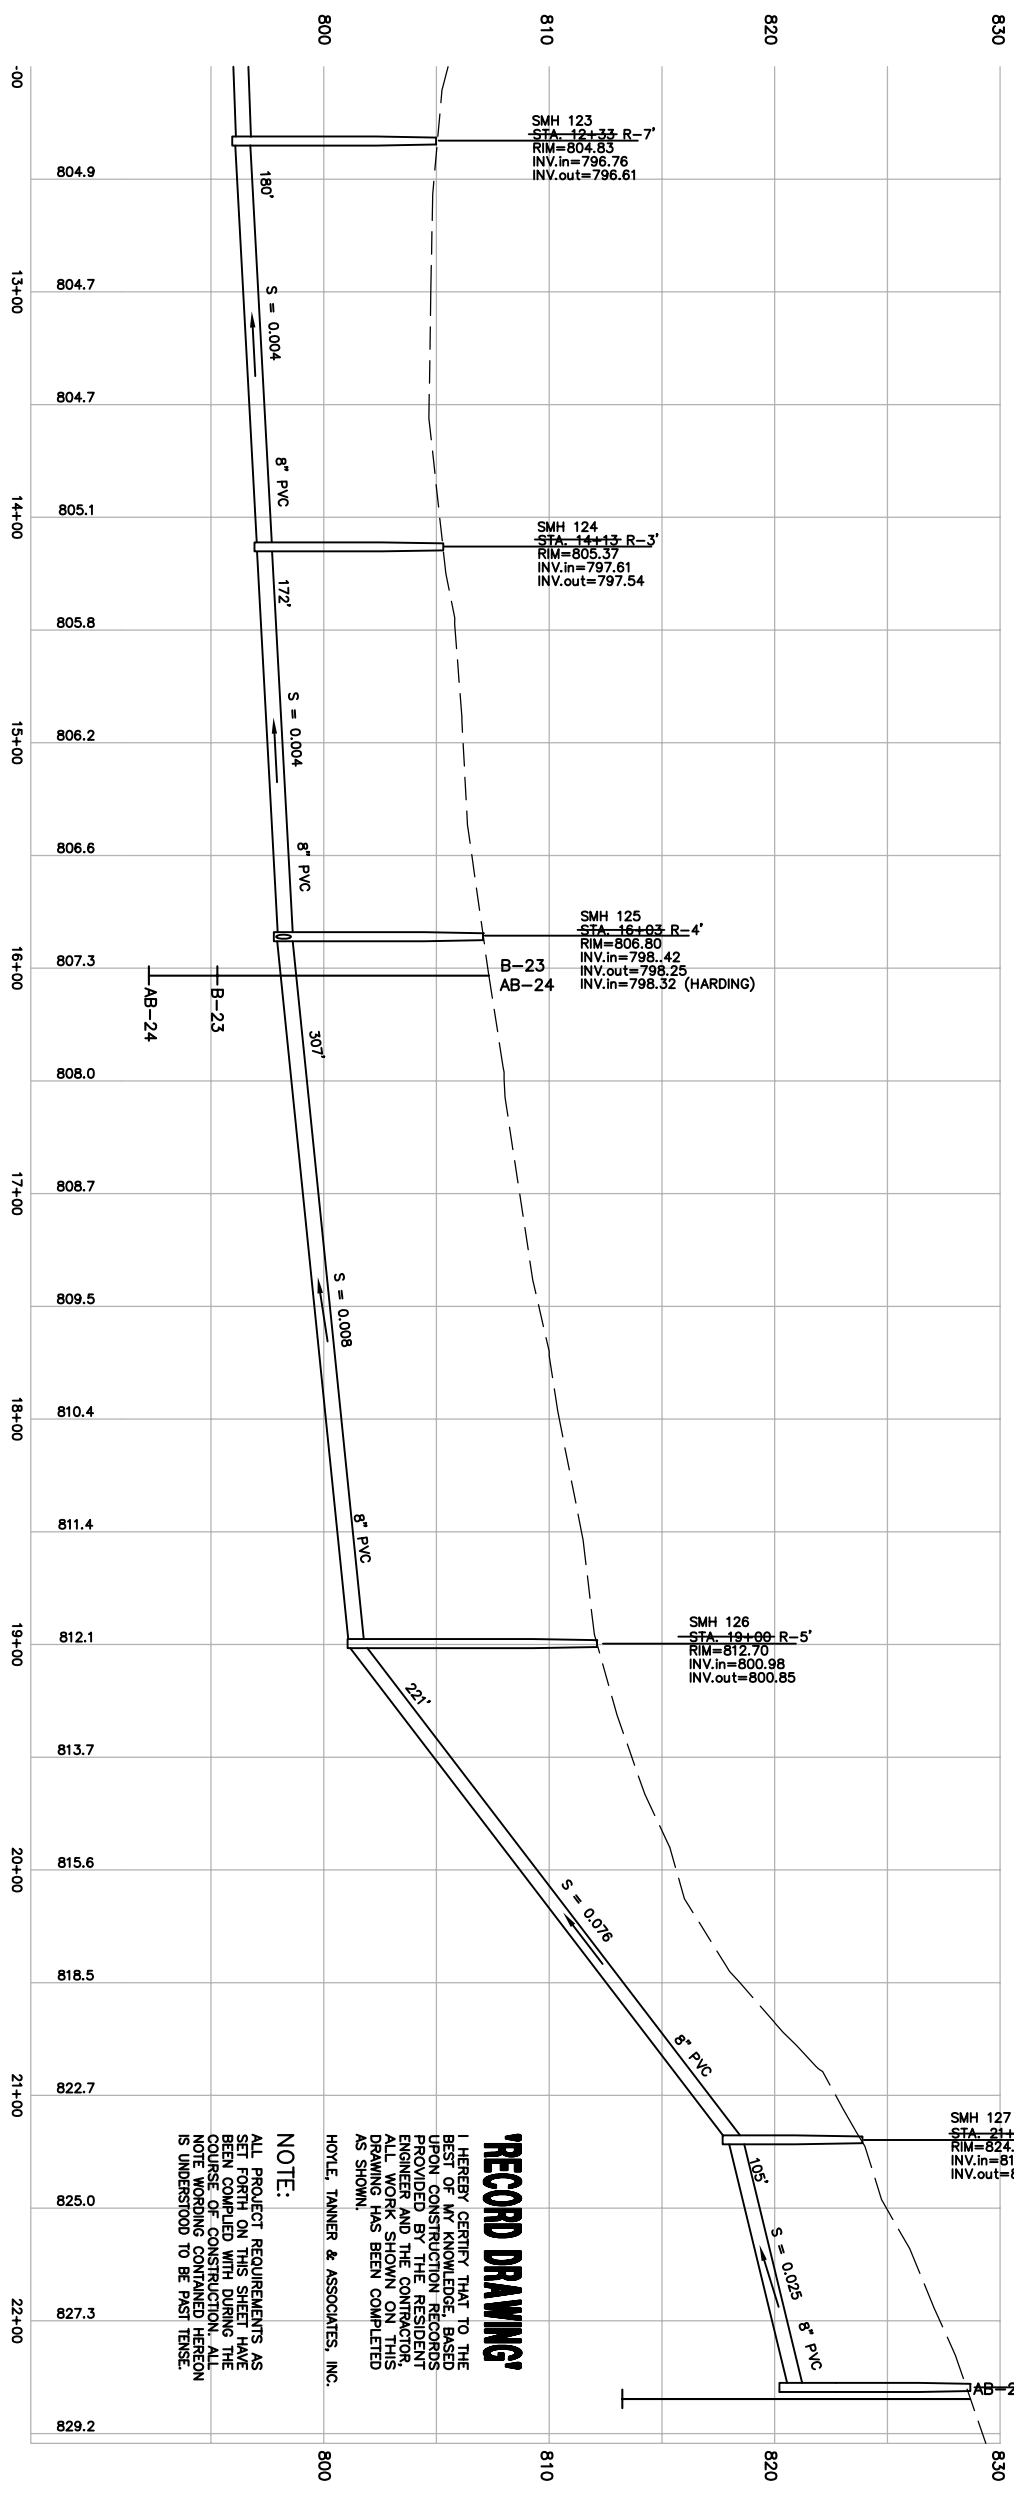


PROFILE
SCALE: 1"=40' HORIZ.
1"=4' VERT.

RECORD DRAWING

I HEREBY CERTIFY THAT TO THE BEST OF MY KNOWLEDGE BASED UPON CONSTRUCTION RECORDS PROVIDED BY THE RESIDENT ENGINEER AND THE CONTRACTOR, ALL WORK SHOWN ON THIS DRAWING HAS BEEN COMPLETED AS SHOWN.

HOYLE, TANNER & ASSOCIATES, INC.

NOTE:
ALL PROJECT REQUIREMENTS AS SET FORTH ON THIS SHEET HAVE BEEN OBTAINED FROM THE COURSE OF CONSTRUCTION. ALL NOTE WORDING CONTAINED HEREON IS UNDERSTOOD TO BE PAST TENSE.

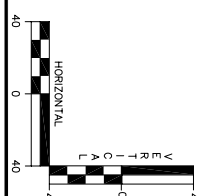

SHEET 32 OF 38	DRAWING NO. 32	CHERRY VALLEY SEWER DISTRICT LEICESTER, MASSACHUSETTS	Hoyle, Tanner & Associates, Inc. Consulting Engineers 150 Dow Street • Manchester • New Hampshire 03101	PROJECT NO. 105709	ENGINEER/ARCHITECT C.B. W.C. W.C. 10/02 DR. CHD. APPD. DATE	
		PLAN AND PROFILE WILLOW HILL ROAD		SCALE: AS SHOWN		DATE: APRIL 2001