


PLAN
SCALE: 1"=40'

MATCH LINE SEE SHEET 28 OF 38

MATCH LINE SEE SHEET 32 OF 38

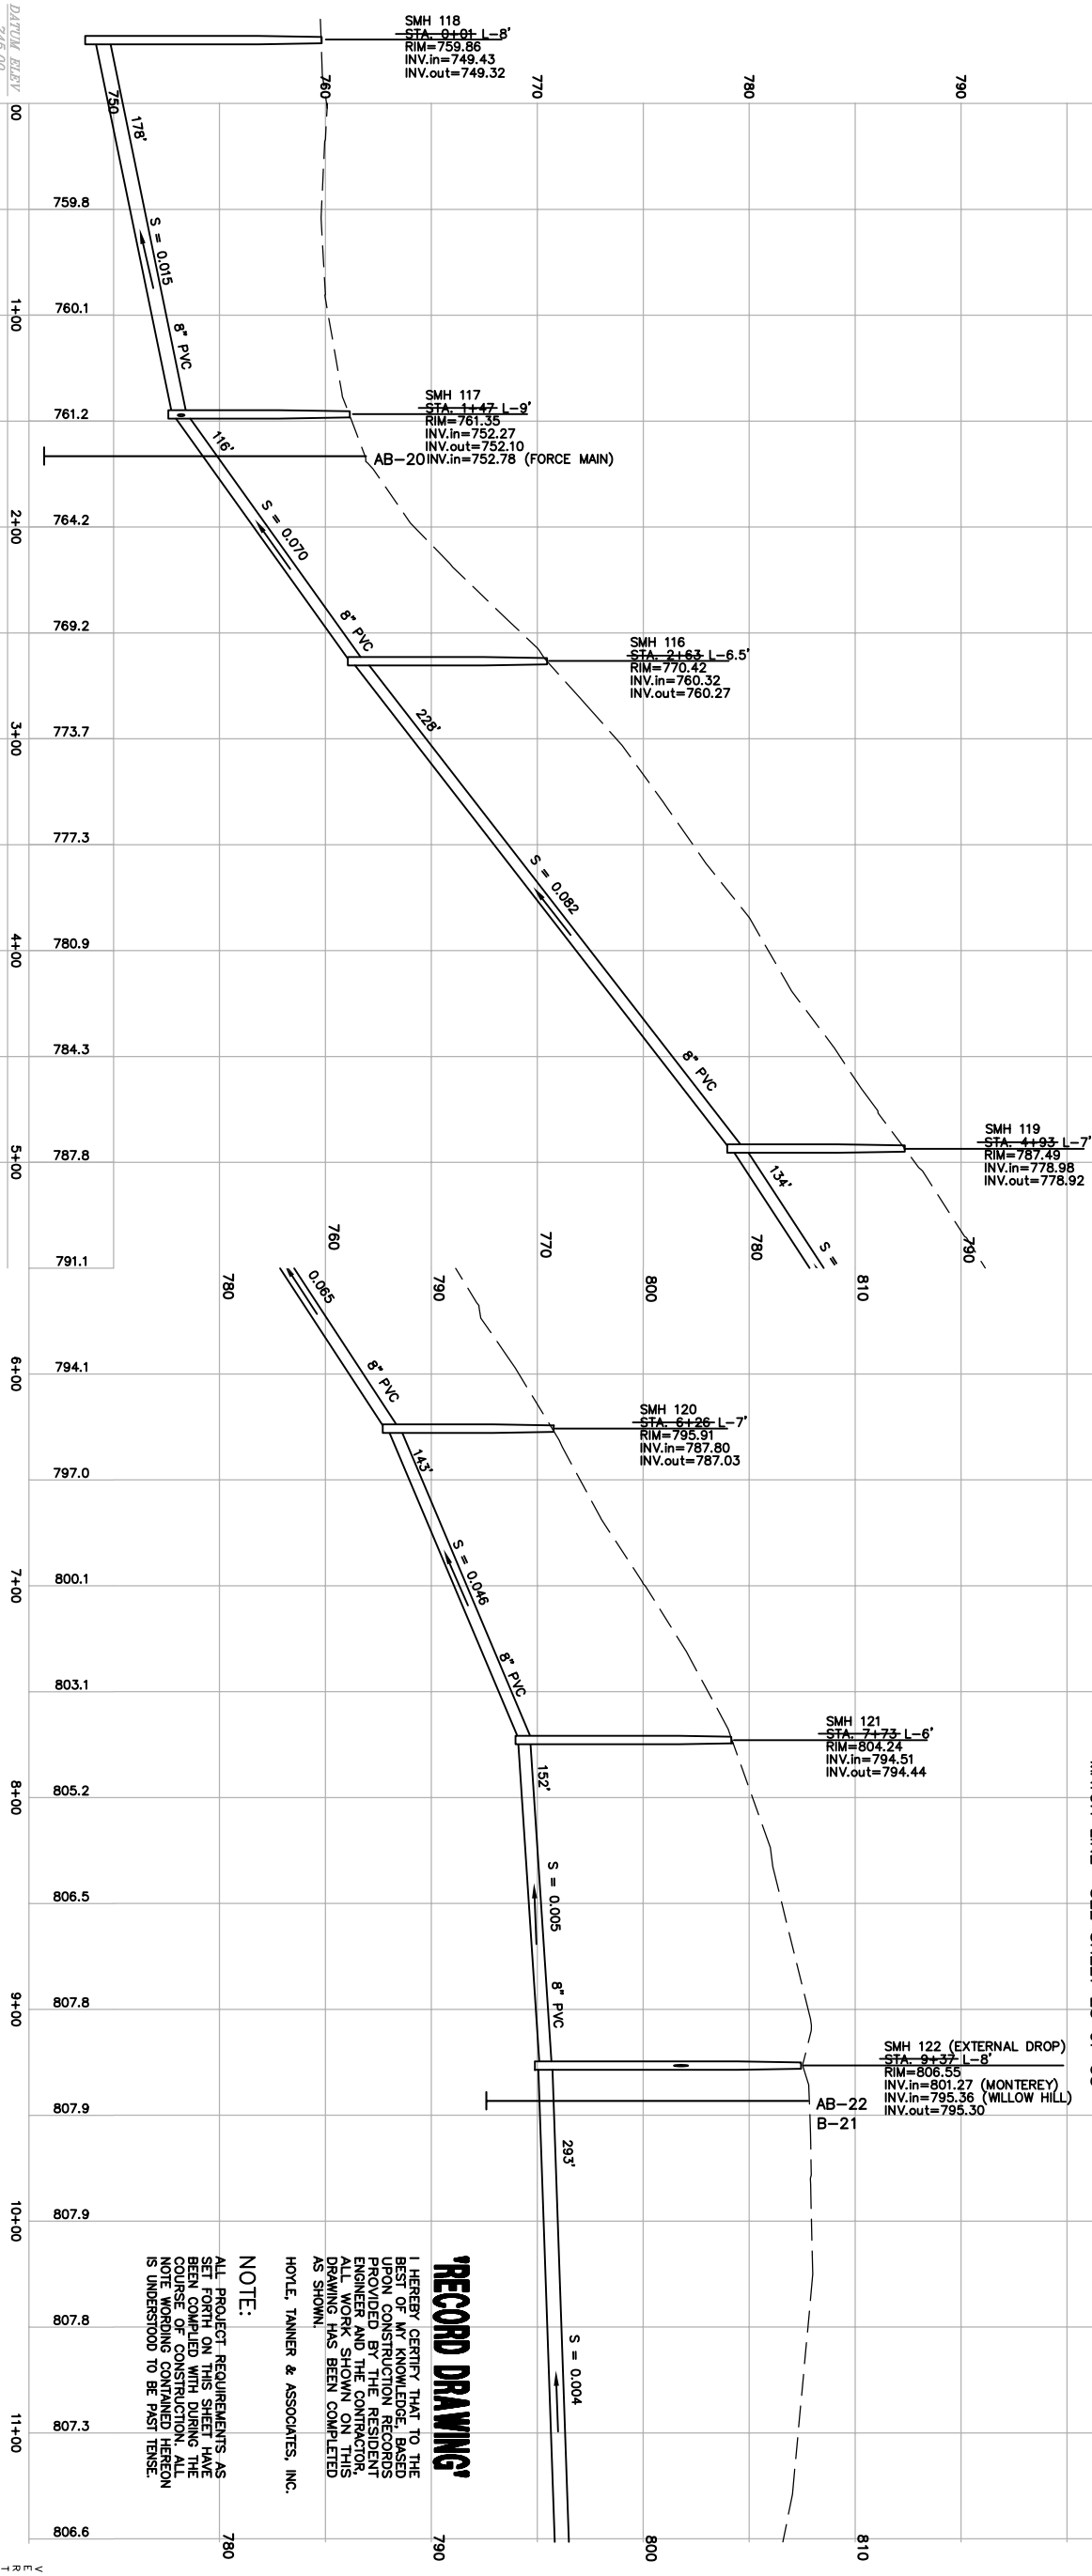

PROFILE
SCALE: 1"=40' HORIZ.
1"=4' VERT.

RECORD DRAWING

I HEREBY CERTIFY THAT TO THE BEST OF MY KNOWLEDGE BASED UPON THE INFORMATION PROVIDED BY THE RESIDENT ENGINEER AND THE CONTRACTOR ALL WORK SHOWN ON THIS DRAWING HAS BEEN COMPLETED AS SHOWN.

HOYLE, TANNER & ASSOCIATES, INC.

NOTE:
ALL PROJECT REQUIREMENTS AS SET FORTH ON THIS SHEET HAVE BEEN COMPLIED WITH DURING THE COURSE OF CONSTRUCTION. ALL NOTE WORKING COMPANED PERSON IS UNDERSTOOD TO BE FIRST TENSE.

SHEET 31 OF 38	DRAWING NO. 31	CHERRY VALLEY SEWER DISTRICT LEICESTER, MASSACHUSETTS	Hoyle, Tanner & Associates, Inc. 150 Dow Street • Manchester • New Hampshire 03101 Consulting Engineers	PROJECT NO. 105709	ENGINEER/ARCHITECT DR. BY CHKD. BY APPD. BY DATE
		PLAN AND PROFILE WILLOW HILL ROAD		FILE NAME ABPROF-31	
		SCALE: AS SHOWN	DATE: APRIL 2001	DES. BY JAH	DR. BY CAB/RCP
				CHKD. BY NLT	
				DO NOT SCALE DRAWING	1. RECORD DRAWING C.B. W.C. W.C. 10/02