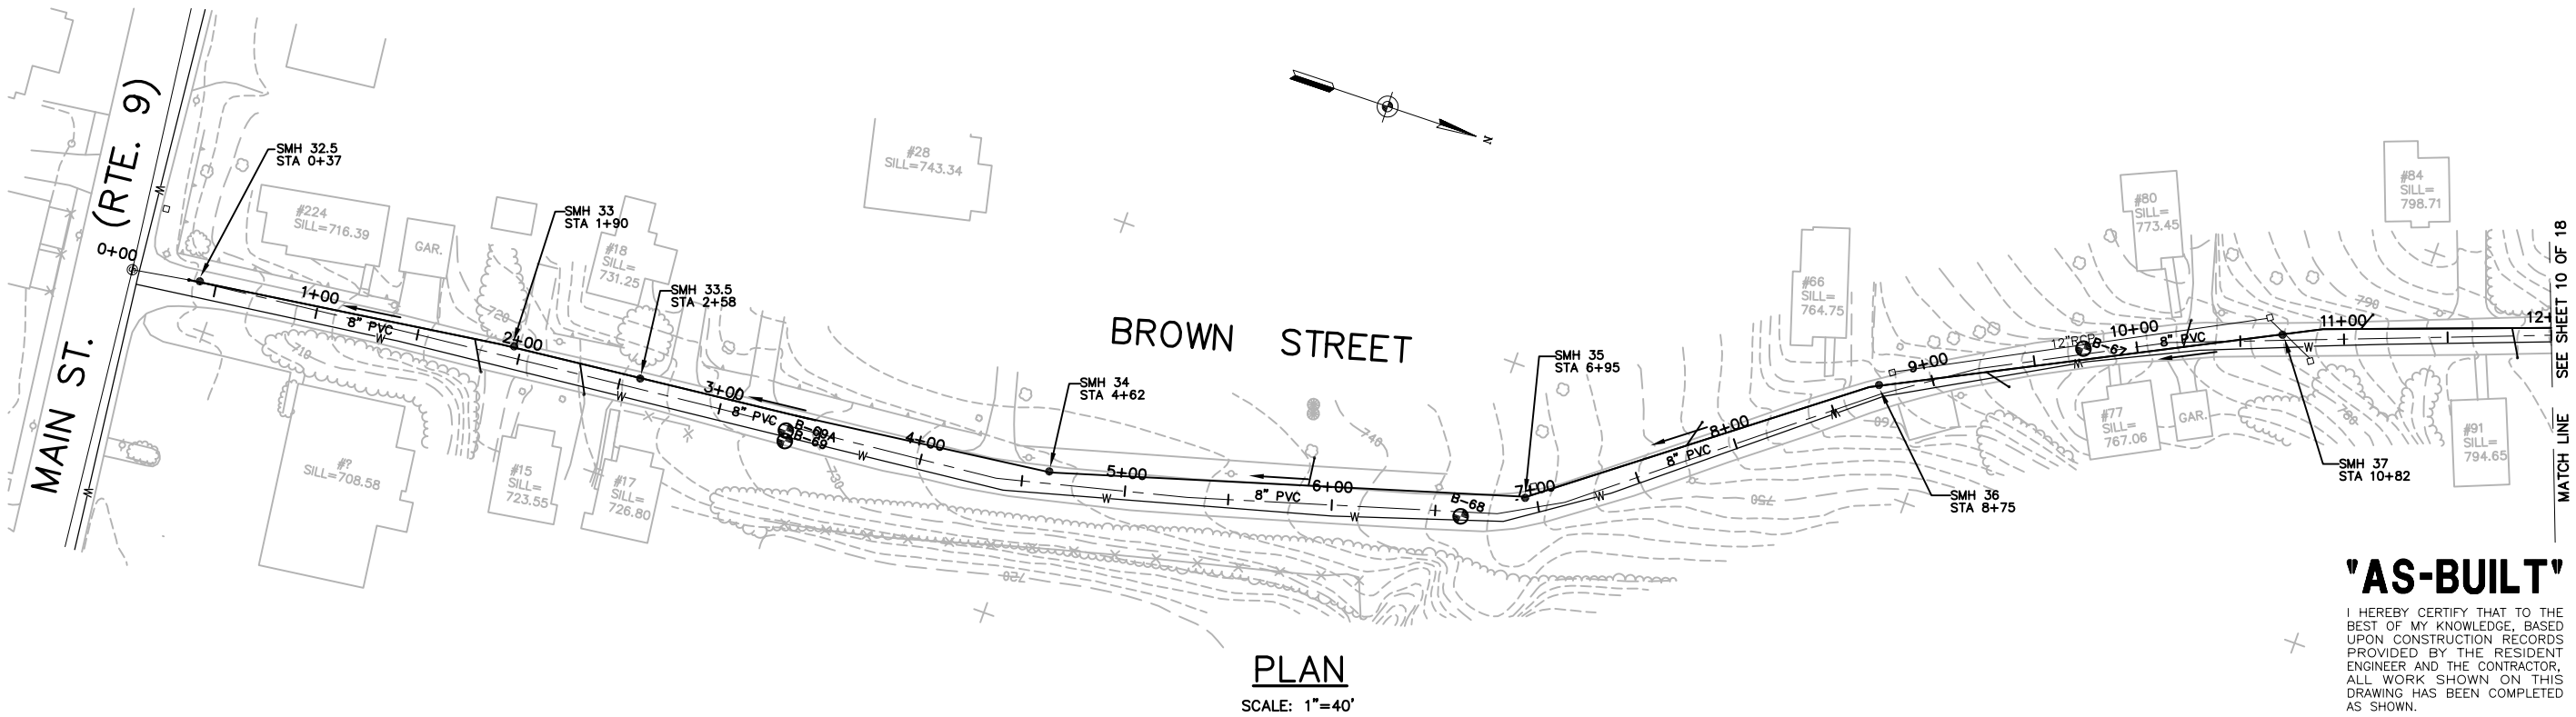

PLAN

SCALE: 1"=40'

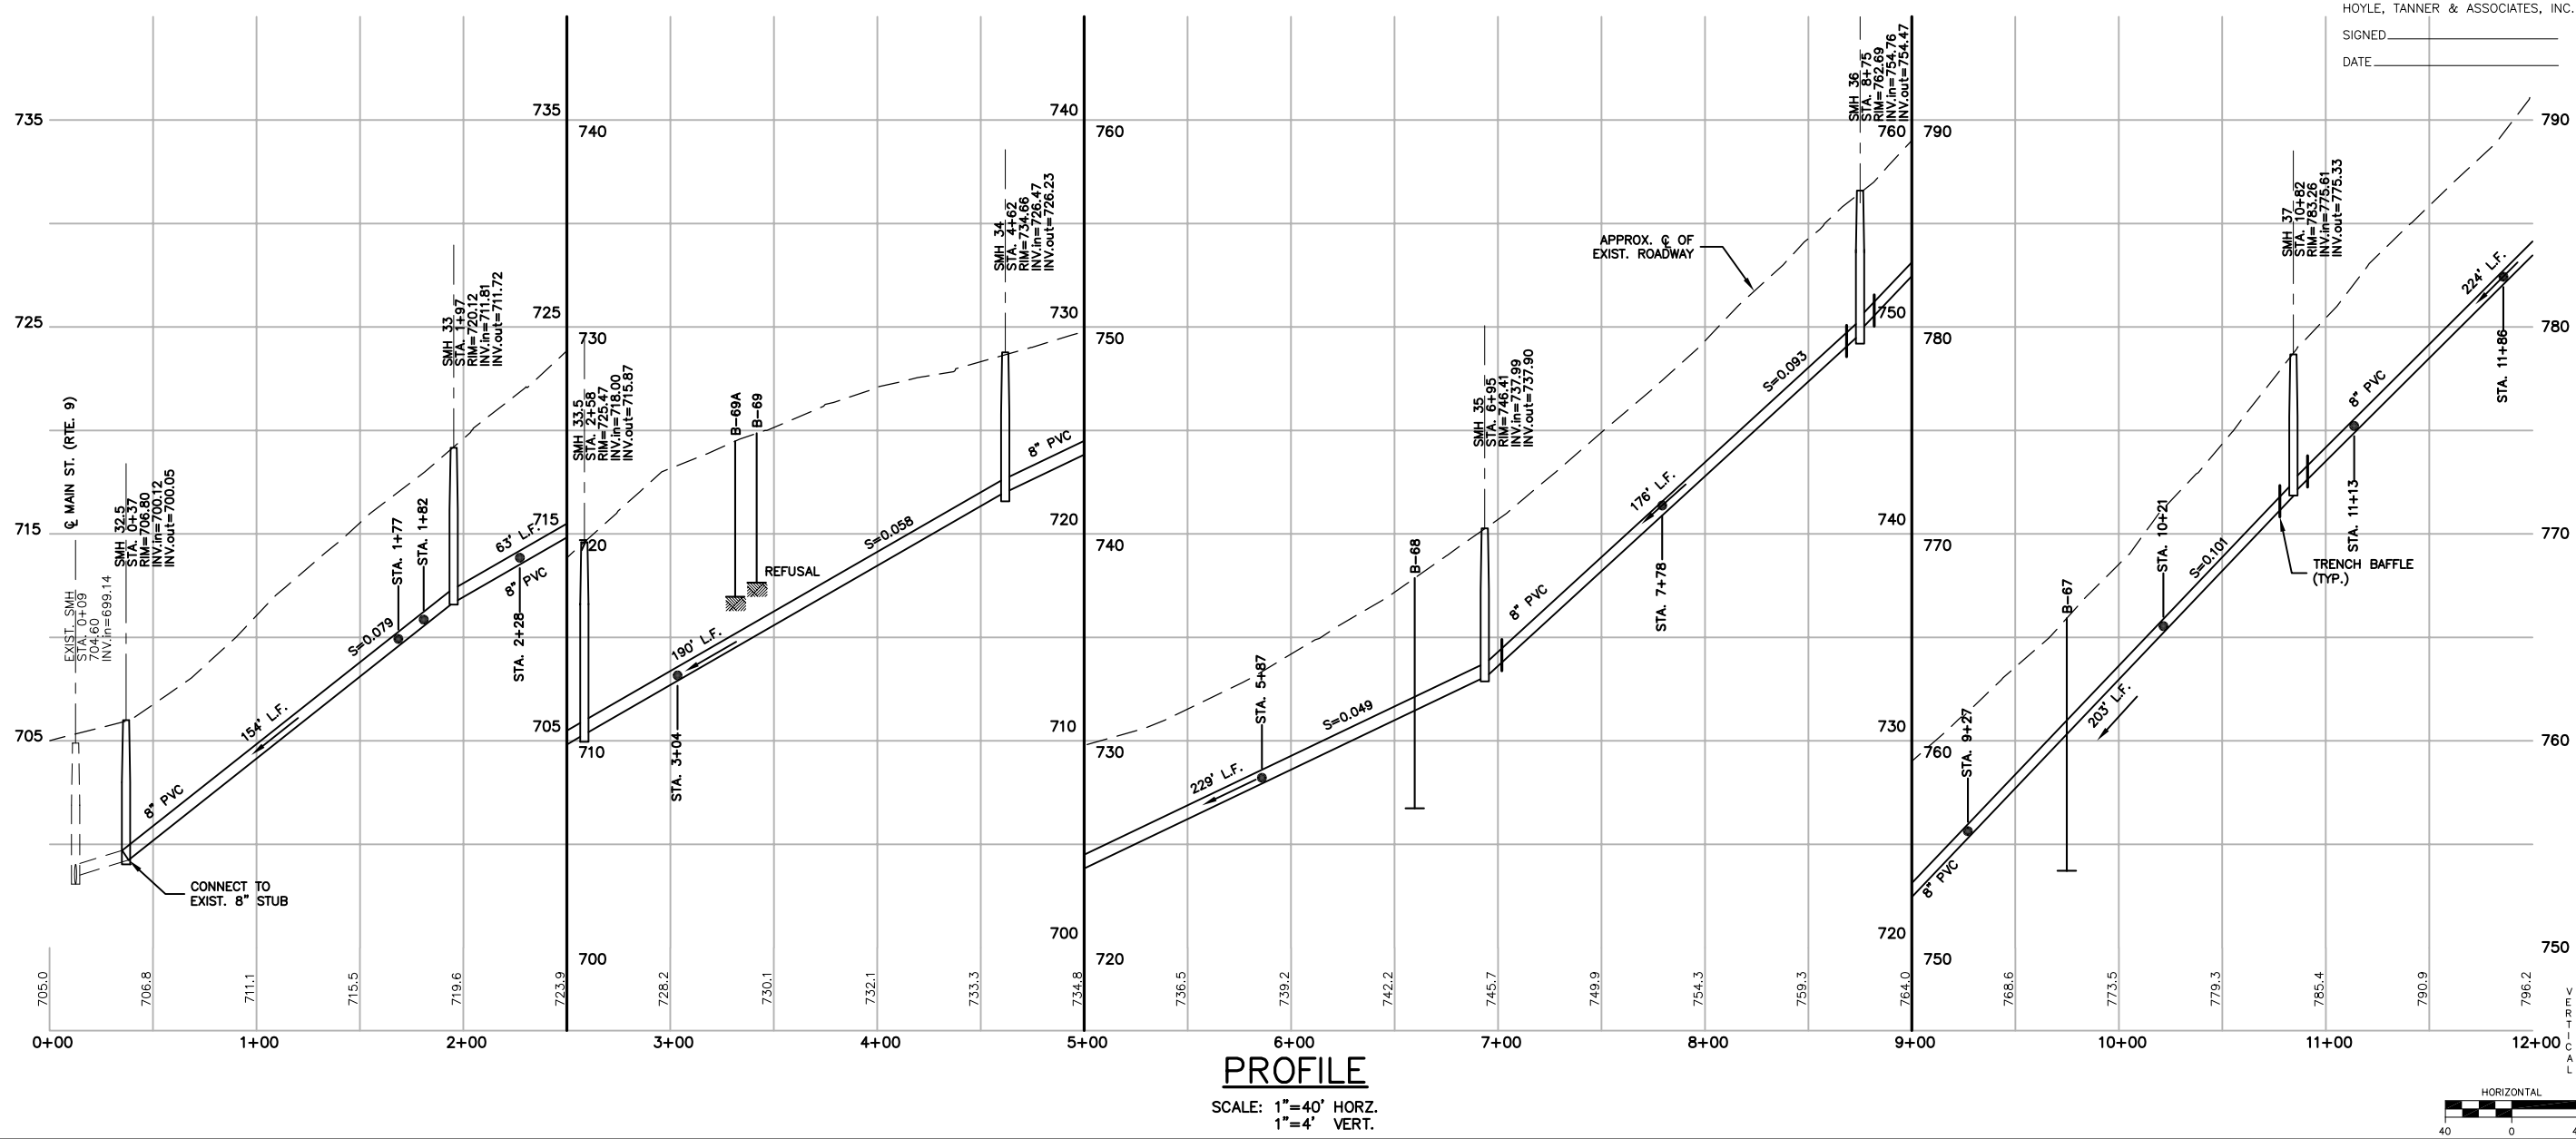

PROFILE

SCALE: 1"=40' HORZ.
1"=4' VERT.

"AS-BUILT"

I HEREBY CERTIFY THAT TO THE BEST OF MY KNOWLEDGE, BASED UPON CONSTRUCTION RECORDS PROVIDED BY THE RESIDENT ENGINEER AND THE CONTRACTOR, ALL WORK SHOWN ON THIS DRAWING HAS BEEN COMPLETED AS SHOWN.

HOYLE, TANNER & ASSOCIATES, INC.

SIGNED _____

DATE _____

ENGINEER/ARCHITECT

REV.	DESCRIPTION	DR. BY	CHKD. BY	APPD. BY	DATE
1.	AS-BUILTS	C.B.	J.H.	J.H.	12/00

PROJECT NO. 105707

FILE NAME AB105P08

DO NOT SCALE DRAWING

Hoyle, Tanner & Associates, Inc.
Consulting Engineers
150 Dow Street • Manchester • New Hampshire 03101

DES. BY JAH | DR. BY RCP | CHKD. BY NLT

DATE: APRIL 2000

SCALE: AS SHOWN

CHERRY VALLEY SEWER DISTRICT
LEICESTER, MASSACHUSETTS
PLAN AND PROFILE

BROWN STREET
0+00 TO 12+00

DRAWING NO. 9

SHEET 9 OF 18